

City of Prince George
HISTORY SHEET

now 34383

SHEET NUMBER

5351

Roll Number

Legal: LOT'S

BLOCK

D.L.

PLAN

Address:

B.C.F.

NEW

OFFICE

BUILDING

Sanitary Connection: #

SIZE

MATERIAL

INV.

CONNECTED

Water Connection #

12392

SIZE

1 1/2"

MATERIAL

METER

CONNECTED

Storm Connection: #

SIZE

MATERIAL

INV.

CONNECTED

Cash Receipt No's:

WATER

2127

SANITARY

STORM

CURB FROM PROPERTY LINE

PAVEMENT WIDTH

B.C. HYDRO

UNDERGROUND CONNECTION

B.C. TELEPHONE

UNDERGROUND CONNECTION

INLAND GAS


Information Sheets:

Comments:

SITE

PLAN

N.T.S.

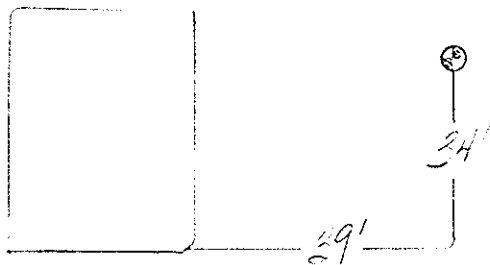

TERMINAL BUILDING ON TERMINAL AVE.