

D

City of Prince George
HISTORY SHEET

SHEET NUMBER 1 of 5

FILE NUMBER 026086654

Legal: LOT 1,

DL 2424, CARIBOO DISTRICT

PLAN BCP14105

Address: 8588 SPARROW RD.

Sanitary Connection: # SIZE: 100mm# MATERIAL: PVC INV. 762.81m CONNECTED

Water Connection: # FROM MAIN: 20mm METER

Storm Connection: # SIZE N/A MATERIAL INV. CONNECTED

Cash Receipt No's: WATER SANITARY STORM

CURB FROM PROPERTY LINE N/A PAVEMENT WIDTH 8.1m

B.C. HYDRO O/H U/G CONNECTION


TELUS O/H U/G CONNECTION

B.C. GAS SHAW CABLE

Information Sheets:

Comments:

THE INFORMATION CONTAINED HEREIN IS FOR INTERNAL USE ONLY.
NOT TO BE RELIED UPON UNLESS CONFIRMED BY THE SITE INSPECTION AND/OR INVESTIGATION

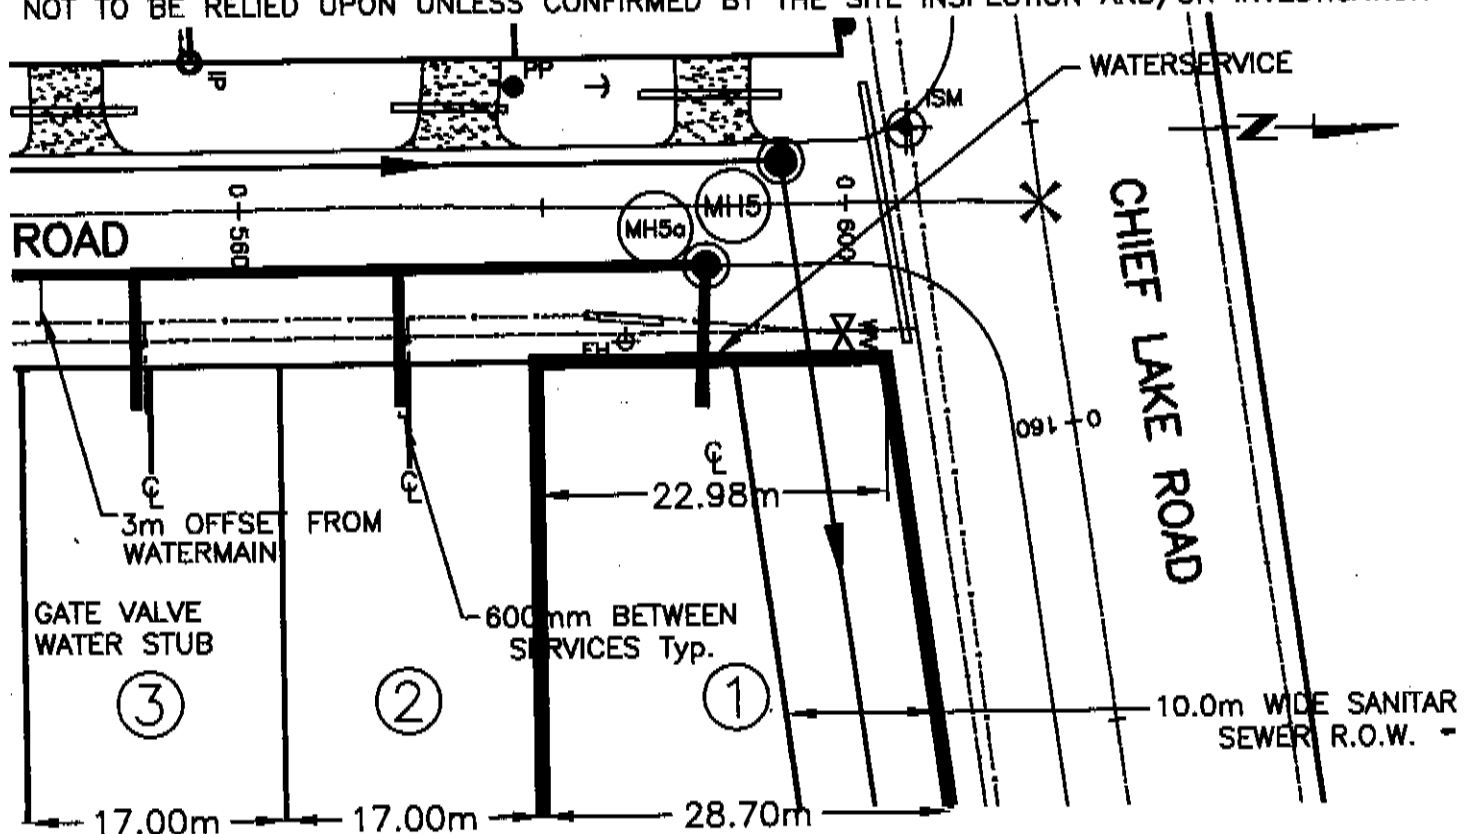

DES 3m INTO PROPERTY