

City of Prince George
HISTORY SHEET

D

SHEET NUMBER 5 of 5

ROLL NUMBER 026086697

Legal: LOT 5, 1, DL 2424, CARIBOO DISTRICT, PLAN BCP 14105

Address: 8458 SPARROW RD

Sanitary Connection: # SIZE: 100mm# MATERIAL: PVC INV. 762.12m CONNECTED

Water Connection: # FROM MAIN: 20mm METER

Storm Connection: # SIZE N/A MATERIAL INV. CONNECTED

Cash Receipt No's: WATER SANITARY STORM

CURB FROM PROPERTY LINE N/A PAVEMENT WIDTH 8.0m

B.C. HYDRO O/H U/G CONNECTION


TELUS O/H U/G CONNECTION

B.C. GAS SHAW CABLE

Information Sheets:

Comments:

THE INFORMATION CONTAINED HEREIN IS FOR INTERNAL USE ONLY.
NOT TO BE RELIED UPON UNLESS CONFIRMED BY THE SITE INSPECTION AND/OR INVESTIGATION

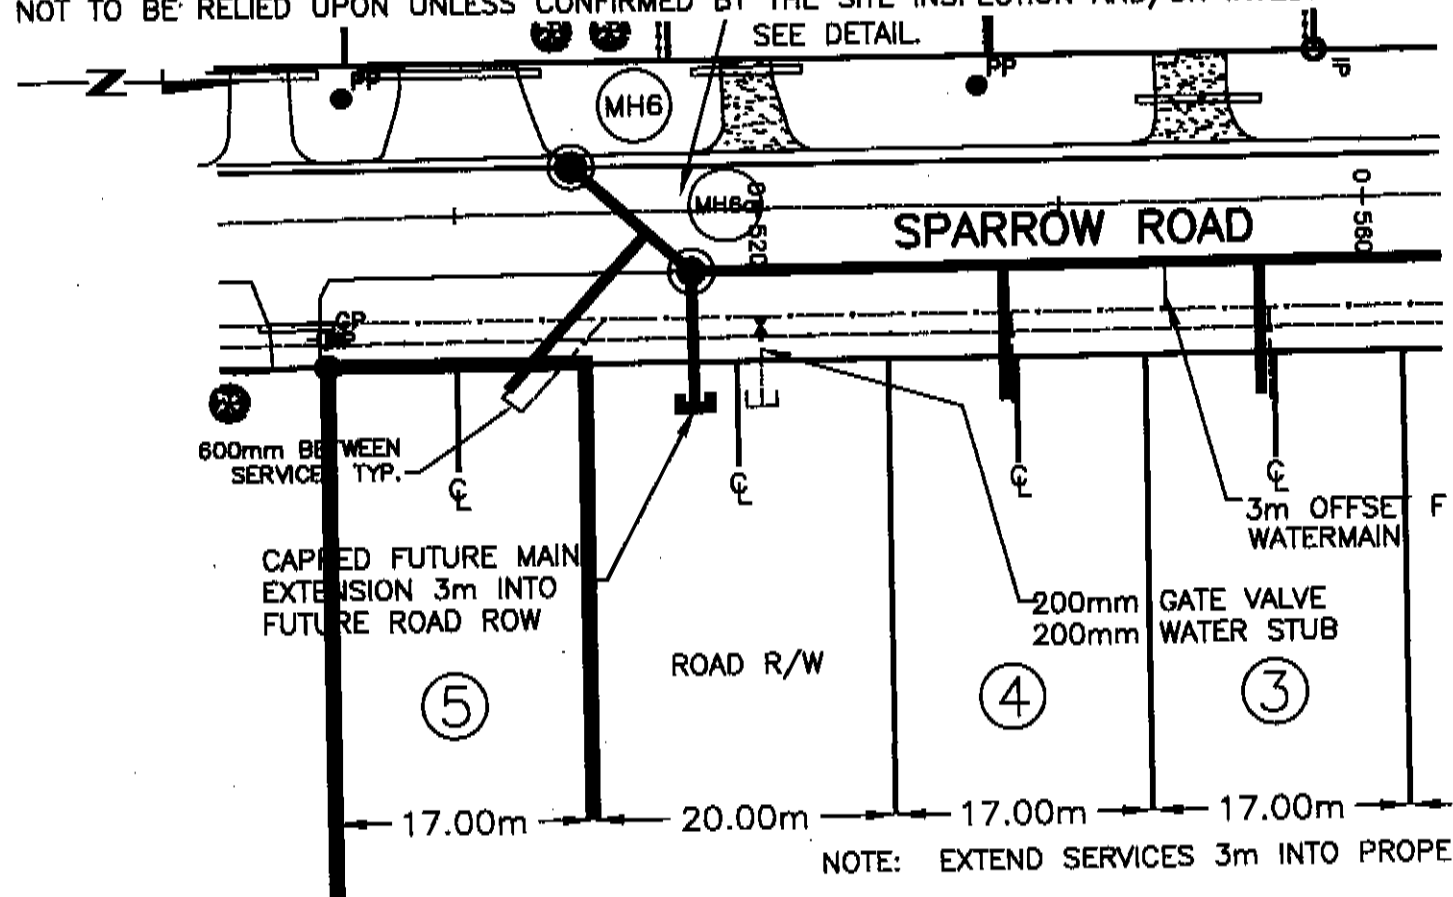

PLAN
SCALE: NTS