


Lot Servicing

1790 HWY 97 S

PID: 026110393

Lot: PCL 1, Plan: BCP14496, DL: 913

SERVICE	SIZE	MATERIAL	INSTALLED DATE	LOCATION	DETAILS
WATER	150MM	UNKNOWN	04-Nov-2004	15.9M E OF W PL (ON ST LAURENT AVE)	CASH RECEIPT NUMBER MU100311
SANITARY	150MM	UNKNOWN	04-Nov-2004	FROM MH# HJ84D	DIFF OR CUT BELOW @ P/L 2.100
SANITARY	200MM	UNKNOWN	04-Nov-2004	75.0M E OF W PL (ON ST LAURENT)	CONNECTION # 18875
STORM	200MM	UNKNOWN	04-Nov-2004	72.3M E OF W PL; FR MH ON ST LAURENT	DIFF OR CUT @ P/L 3.20
STORM	250MM	UNKNOWN	04-Nov-2004	67.3M E OF W PL; FR MH ON ST LAURENT	CONNECTION # 18876

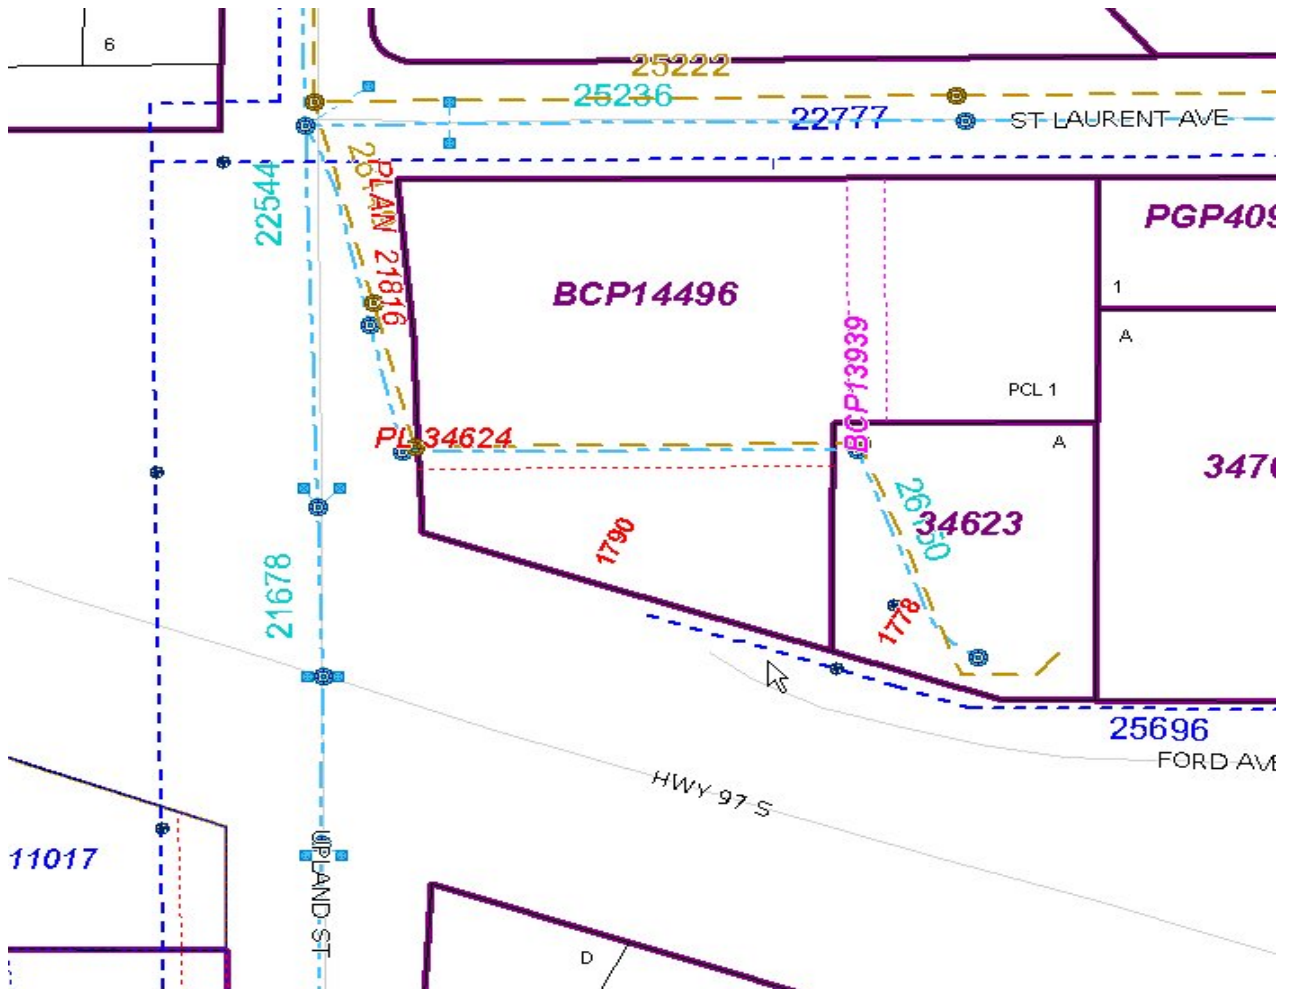

Accuracy not guaranteed unless confirmed by site inspection and/or investigation.
Connection location between main and property line only.