

D


Lot Servicing

4377 HILL AVE

PID: 026339391

Lot: A, Plan: BCP18606, DL: 2507 & DL482

	Size (mm)	Material	Invert @ PL	Cut @ PL	Survey Date	Field Book	Location	Comments
Sanitary	200							
Water	150							
Storm	250							

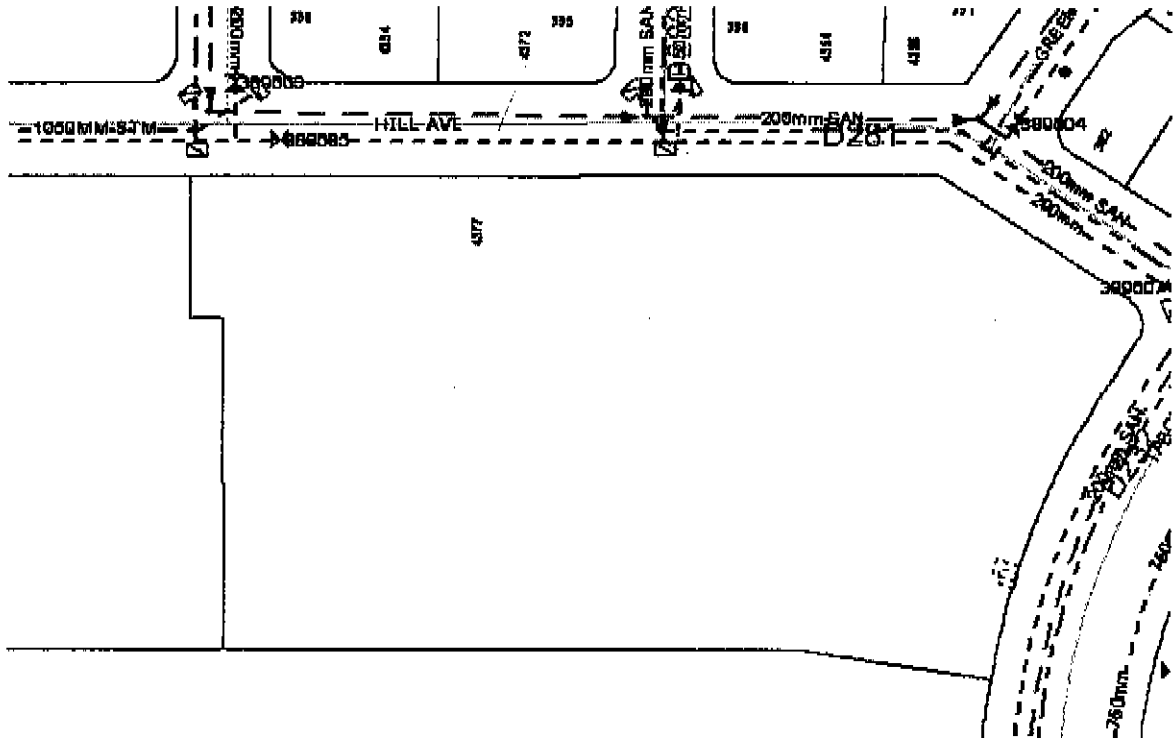

Accuracy not guaranteed unless confirmed by site inspection and/or investigation.
Connection location between main and property line only.