


Lot Servicing

2189 LAURIER CRES

PID: 026347768

Lot: B, Block: 121, Plan: 1268, DL: 343 (BX539016)

SERVICE	SIZE	MATERIAL	INSTALLED DATE	LOCATION	DETAILS
WATER	20MM	CU		WATER CROSSES OVER TO PROPERTY FROM LOT 24 (2189 LAURIER CR) - SP 2.3M S OF N PL	CASH RECEIPT NUMBER 100630
SANITARY	UNKNOWN	UNKNOWN	12-May-1958	161' (47.7M) N OF MH HM72F	CLEANOUT 3.8M S OF N PL 4.3M E

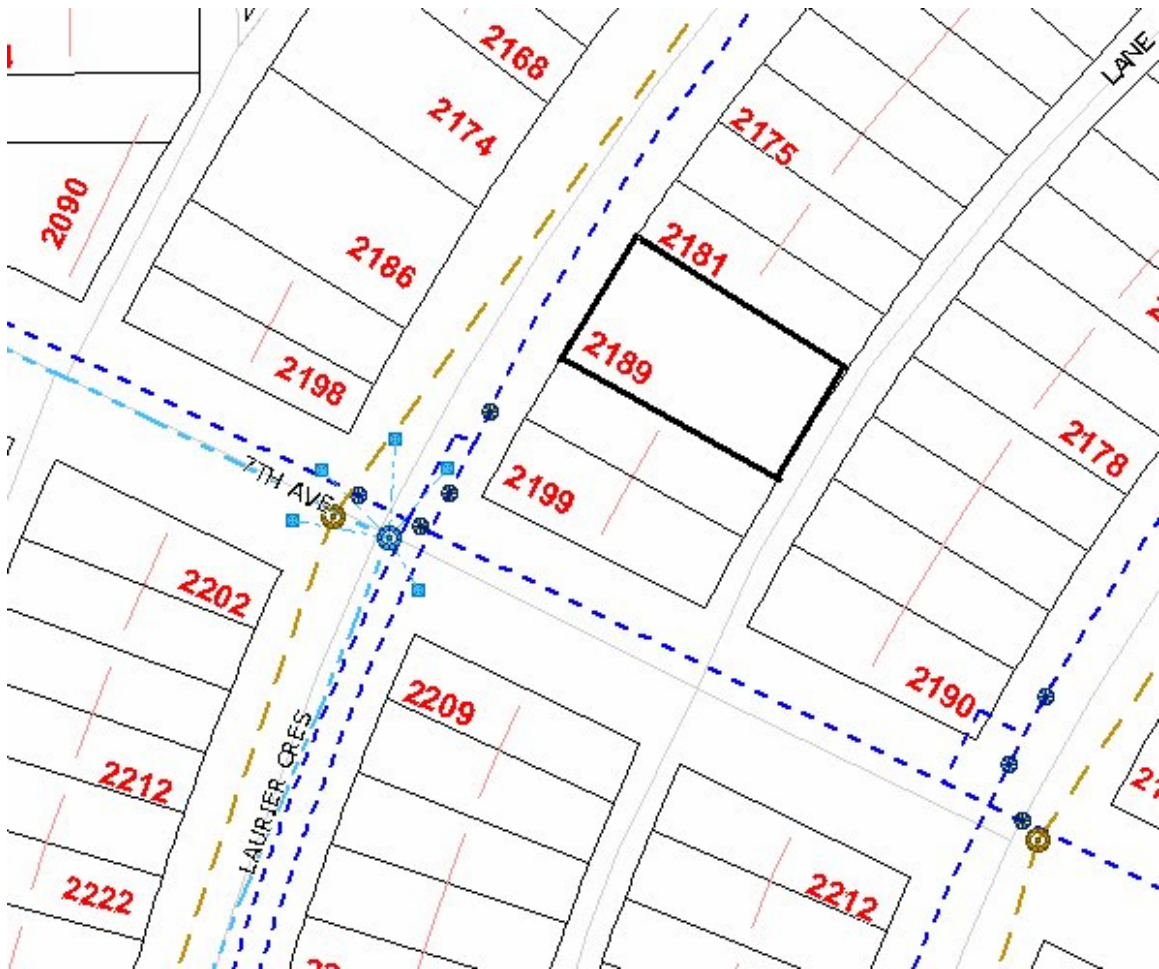

Accuracy not guaranteed unless confirmed by site inspection and/or investigation.
Connection location between main and property line only.