
City of Prince George HISTORY SHEET

PID: 026421500 Legal: D.L. 1599 LOT 1 PLAN BCP 19756 Address: 7101 WESTGATE AVENUE Sanitary Connection:# SIZE: 100mmø MATERIAL: PVC INV. 747.75m CONNECTED Water Connection:# SIZE: 19mmø MATERIAL: COPPER INV. 747.75m METER Storm Connection:# SIZE 100mmø MATERIAL PVC INV. 747.75m CONNECTED Cash Receipt No's: WATER SANITARY STORM CURB FROM PROPERTY LINE 6.0m PAVEMENT WIDTH 13.0m B.C. HYDRO 75mm DB2 U/G CONNECTION B.C. TELEPHONE 50mm DB2 U/G CONNECTION B.C. GAS 42 PROP/P.E. Information Sheets: REF. DWGS. L&M ENGINEERING LTD. JOB. 1064-16-02 DWGS. (001-306) —≽ WATER SERVICE —○ STORM SERVICE SANITARY SERVICE CS CURB STOP = SHALLOW SERVICES (HYDRO, TELECOMMUNICATIONS, CABLE) COO CLEAN OUT Comments:

THE INFORMATION CONTAINED HEREIN IS FOR INTERNAL USE ONLY.
NOT TO BE RELIED UPON UNLESS CONFIRMED BY THE SITE INSPECTION AND/OR INVESTIGATION

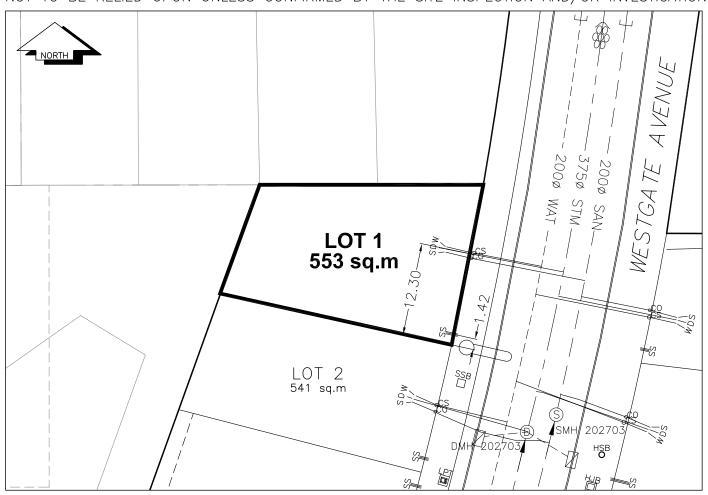

SANITARY, STORM & WATER SERVICE INVERTS	SANITARY	STORM	WATER
1. Distance from San. M.H. GE33G to connection point is 58.94 toward San. M.H. 202703		N/A	N/A
1a.Distance from Stm. M.H. 203706 to connection point is 54.73 toward Stm. M.H. 202703	N/A		N/A
2. Main Size at connection point is	200mmø	375mmø	200mmø
3. Invert of main at conn. stub pt is	745.44	745.67	746.38
4. Invert at service end is	747.75	747.75	747.75
5. Cut at P/I in meters	2.0m	2.1m	2.0m
6. Survey Date JULY/SEPT 20 05 Book Ref. 1064-16-02 by FORESIGHT			
, 20 2011			
SANITARY HISTORY:			
WATER HISTORY:			
STORM HISTORY:			