

# City of Prince George

## HISTORY SHEET

PID: 026421631

Legal: LOT 14

D.L. 1599

PLAN BCP 19756

Address: 7174 WESTGATE AVENUE

Sanitary Connection:# SIZE: 100mm $\emptyset$  MATERIAL: PVC INV. 748.39m CONNECTED

Water Connection:# SIZE: 19mm $\emptyset$  MATERIAL: COPPER INV. 748.39m METER

Storm Connection:# SIZE: 100mm $\emptyset$  MATERIAL: PVC INV. 748.39m CONNECTED

Cash Receipt No's: WATER SANITARY STORM

CURB FROM PROPERTY LINE 6.0m PAVEMENT WIDTH 13.0m

B.C. HYDRO 75mm DB2 U/G CONNECTION



B.C. TELEPHONE 50mm DB2 U/G CONNECTION




B.C. GAS 42 PROP/P.E.

Information Sheets: REF. DWGS. L&M ENGINEERING LTD. JOB. 1064-16-02 DWGS. (001-306)

Comments: CS<sub>O</sub> CURB STOP SOW WATER SERVICE  
CO<sub>O</sub> CLEAN OUT STORM SERVICE  
SANITARY SERVICE SHALLOW SERVICES  
(HYDRO, TELECOMMUNICATIONS, CABLE)

THE INFORMATION CONTAINED HEREIN IS FOR INTERNAL USE ONLY.  
NOT TO BE RELIED UPON UNLESS CONFIRMED BY THE SITE INSPECTION AND/OR INVESTIGATION

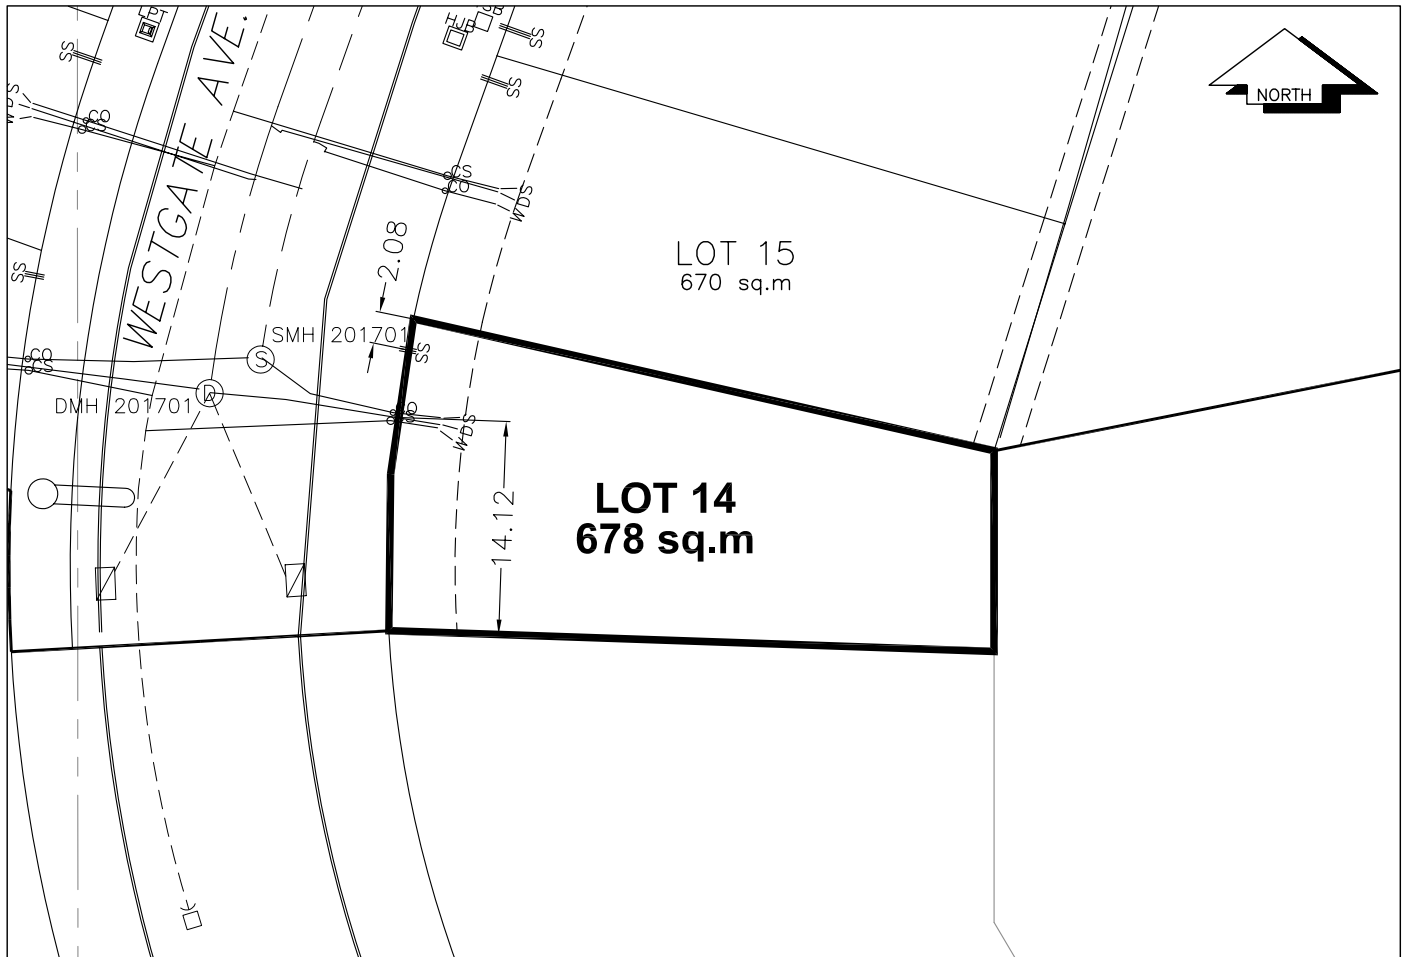

| SANITARY, STORM & WATER SERVICE INVERTS                          | SANITARY | STORM  | WATER  |
|--|----------|--------|--------|
| 1. Distance from San. M.H.201701 to connection point is00.00     |          | N/A    | N/A    |
| 1a.Distance from Stm. M.H. 201701 to connection point is00.00    | N/A      |        | N/A    |
| 2. Main Size at connection point is                              | 200mmØ   | 300mmØ | 200mmØ |
| 3. Invert of main at conn. stub pt is                            | 748.04   | 747.75 | 746.44 |
| 4. Invert at service end is                                      | 748.45   | 748.37 | 748.32 |
| 5. Cut at P/I in meters  | 2.3m     | 2.3m   | 2.3m   |
| 6. Survey Date JULY/SEPT 20 05 Book Ref. 1064-16-02 by FORESIGHT |          |        |        |
|  |          |        |        |
|  |          |        |        |
SANITARY HISTORY:

---

---

WATER HISTORY:

---

---

STORM HISTORY:

---

---

