

City of Prince George

HISTORY SHEET

PID: 026421747

Legal: LOT 25 D.L. 1599 PLAN BCP 19756

Address: 7108 WESTGATE AVENUE

Sanitary Connection:# SIZE: 100mmØ MATERIAL: PVC INV. 748.56m CONNECTED

Water Connection:# SIZE: 19mmØ MATERIAL: COPPER INV. 748.53m METER

Storm Connection:# SIZE: 100mmØ MATERIAL: PVC INV. 748.56m CONNECTED

Cash Receipt No's: WATER SANITARY STORM

CURB FROM PROPERTY LINE 6.0m PAVEMENT WIDTH 13.0m

B.C. HYDRO 75mm DB2 U/G CONNECTION ✓


B.C. TELEPHONE 50mm DB2 U/G CONNECTION ✓

B.C. GAS 42 PROP/P.E.

Information Sheets: REF. DWGS. L&M ENGINEERING LTD. JOB. 1064-16-02 DWGS. (001-306)

Comments: CS_O CURB STOP SDW WATER SERVICE
CO_O CLEAN OUT STORM SERVICE
SSB SANITARY SERVICE SHALLOW SERVICES
(HYDRO, TELECOMMUNICATIONS, CABLE)

THE INFORMATION CONTAINED HEREIN IS FOR INTERNAL USE ONLY.
NOT TO BE RELIED UPON UNLESS CONFIRMED BY THE SITE INSPECTION AND/OR INVESTIGATION

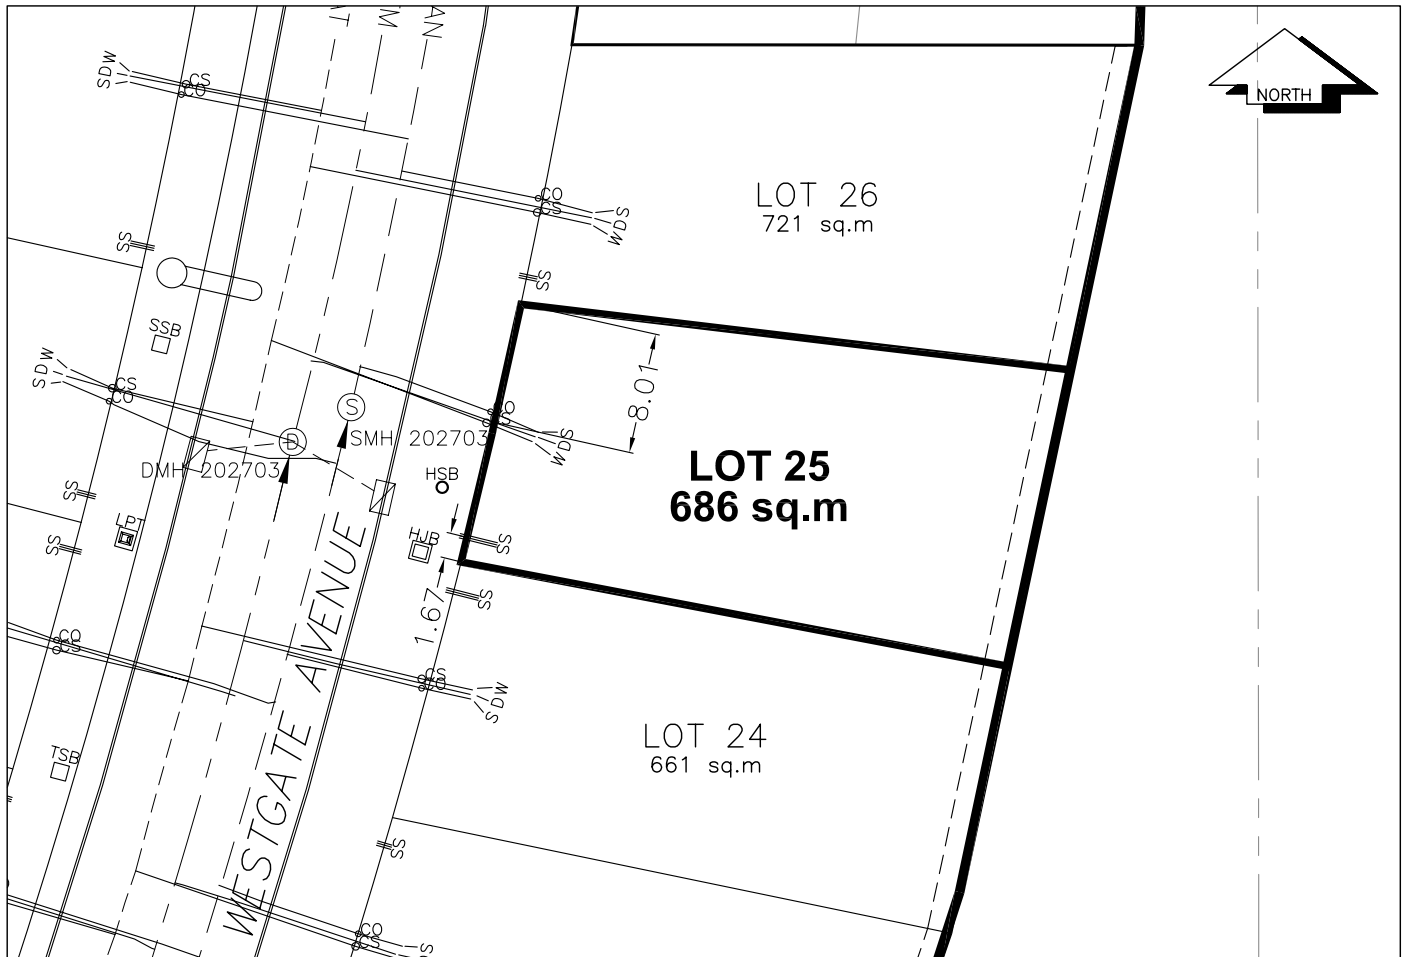

SANITARY, STORM & WATER SERVICE INVERTS	SANITARY	STORM	WATER
1. Distance from San. M.H. GE33G to connection point is 74.00 toward San. M.H. 202703		N/A	N/A
1a.Distance from Stm. M.H. 203706 to connection point is 70.56 toward Stm. M.H. 202703	N/A		N/A
2. Main Size at connection point is	200mmØ	375mmØ	200mmØ
3. Invert of main at conn. stub pt is	746.61	746.58	747.00
4. Invert at service end is	748.56	748.56	748.53
5. Cut at P/I in meters	2.3m	2.3m	2.3m
6. Survey Date JULY/SEPT 20 05 Book Ref. 1064-16-02 by FORESIGHT			

SANITARY HISTORY:

WATER HISTORY:

STORM HISTORY:
