

Lot Servicing


6742 O'GRADY RD

PID: 026428903

Lot: 3, Plan: BCP19860, DL: 754

SERVICE	SIZE	MATERIAL	INSTALLED DATE	LOCATION	DETAILS
WATER	20MM	CU	30-Jun-2005		CASH RECEIPT NUMBER MU100382
SANITARY	100MM	PVC	30-Jun-2005		RECEIPT # MU100382
STORM	100MM	PVC	30-Jun-2005		RECEIPT # MU100382

Accuracy not guaranteed unless confirmed by site inspection and/or investigation.
Connection location between main and property line only.

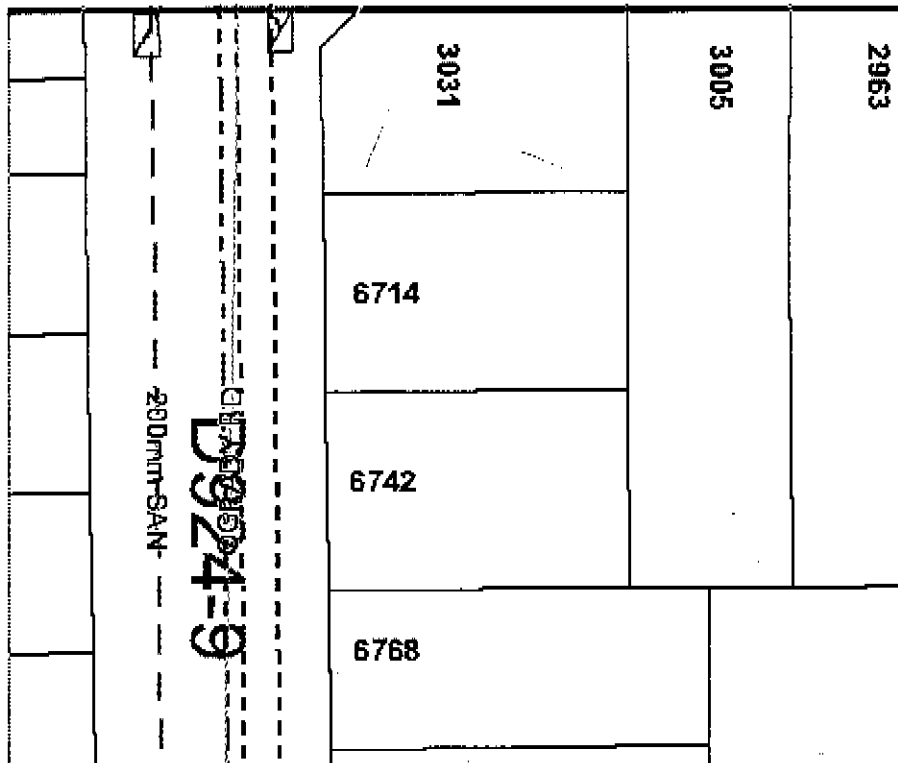

Accuracy not guaranteed unless confirmed by site inspection and/or investigation.
Connection location between main and property line only.