


Lot Servicing

4256 ESTAVILLA DR

PID: 026441292

Lot: 2, Plan: BCP20079, DL: 2433

SERVICE	SIZE	MATERIAL	INSTALLED DATE	LOCATION	DETAILS
WATER	20MM	CU		11.6M S NE CORNER BLDG	CASH RECEIPT NUMBER 16570
SANITARY	100MM	PVC	05-Sep-1985	64.0M W E PL	CUT @ P/L @ DATE OF INSTALLATION 2.1M

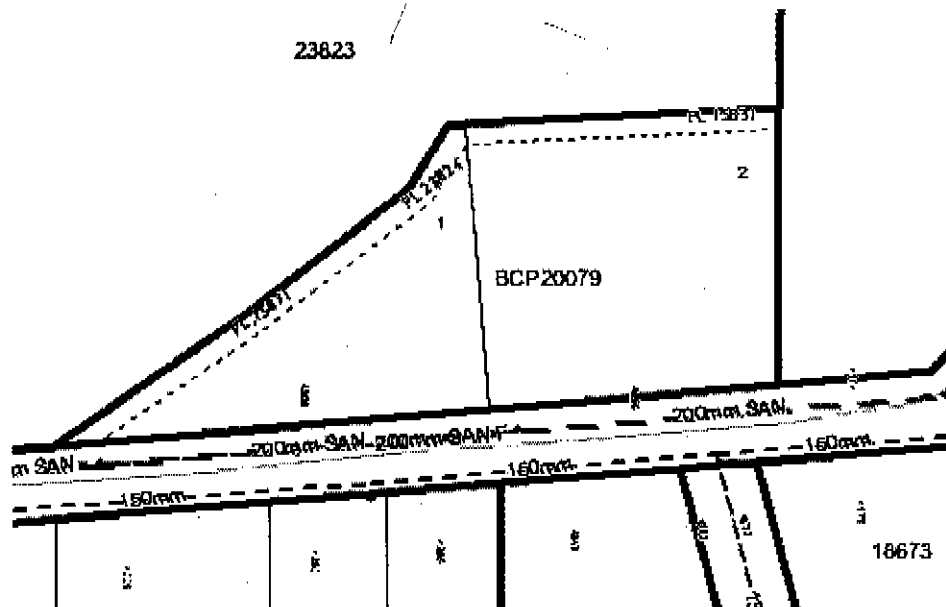

Accuracy not guaranteed unless confirmed by site inspection and/or investigation.
Connection location between main and property line only.