
## City of Prince George HISTORY SHEET

P.I.D. 026 474 174	4800					
Legal: LOT 1			D.L.	4377		PLAN BCP20570
Address: 2394 McTAVISH ROAD			4			
Sanitary Connection: SIZE:	100mmø	MATERIAL:	PVC	INV.	653.58m	CONNECTED
Water Connection: SIZE:	19mmø	MATERIAL:	COPPER	INV.	655.63m	METER
Storm Connection: SIZE	100mmø	MATERIAL	PVC	INV.	655.16m	CONNECTED
Cash Receipt No's:	WATER		SANITARY			STORM
CURB FROM PROPERTY LINE 5.0m	4				PAVEMEN	NT WIDTH 10.0m
B.C. HYDRO 75mm DB2			U/G CONNECT	ION	<u> </u>	
B.C. TELEPHONE 50mm DB2			U/G CONNECTI	ON	/	
B.C. GAS 42 PROP/P.E.						
Information Sheets: REF. DWGS.	L&M ENGINEERING					
Comments: CS CURB STOP COO CLEAN OUT	→ × WATE STOR SANIT	R SERVICE M SERVICE FARY SERVICE	E 三章	HYDRO CABLE TELECO	SERVICE SERVICE OMMUNICATIO	ons

THE INFORMATION CONTAINED HEREIN IS FOR INTERNAL USE ONLY.
NOT TO BE RELIED UPON UNLESS CONFIRMED BY THE SITE INSPECTION AND/OR INVESTIGATION

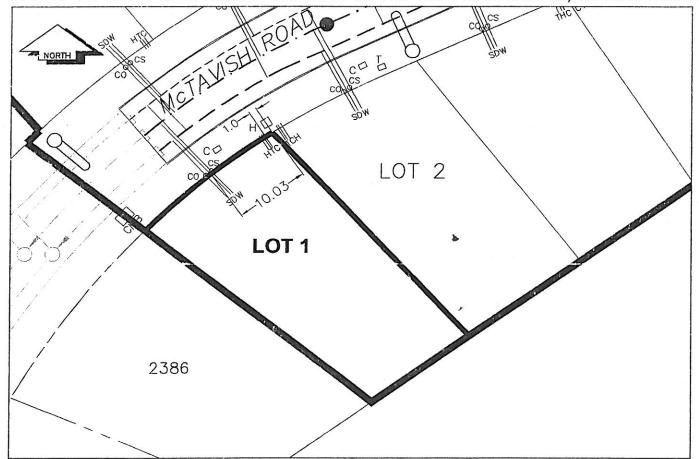

SANITARY, STORM & WATER SERVICE INVERTS	SANITARY	STORM	WATER
1. Distance from San. M.H. S-7 to connection point is 22.93 toward San. MH 5:4602		N/A	N/A
1a.Distance from Stm. M.H. D-8 to connection point is 25.40 toward Stm. MH 513603	N/A		N/A
2. Main Size at connection point is	200mmø	450mmø	250mmø
3. Invert of main at corns. stub pt is	653.25	654.83	655.30
4. Invert ut service end is	653.58	655,16	655.63
5. Cut at P/I in meters	4.7m	3.1m	2.8m
6. Survey Date AUGUST 20 05 Book Ref. 1253-01-03 by KILBRIDE			
d. Survey Dete //OGGG1 20 30 State Aut			
SANITARY HISTORY:			
SANTACT HISTORY.		as never transport with female and the second of a second	A Comment of the Comm
		mentary punchasing harmonic representation of section (see a section (see a section))	
The state of the s		and place of the second property and other second or the second of the second or the s	V ( )
	and the second s	THE REAL PROPERTY OF THE PERSON OF THE PERSO	, , , , , , , , , , , , , , , , , , , ,
The second of th	AND THE PERSON AND TH		Comment of the second of the s
		raging regressive lighted the designation of the control of the co	
	and the state of t	the bring is the special particular of the delimination of the second state of	
WATER HISTORY:			Andrew Control of the State of
			Annah, 2000000 10000000 p. 100000 1000000
	A COMMISSION OF THE PARTY OF TH		
	and the state of t	man reduces to comment of the comment of the control of the contro	
			Annessed Vini, St., 167 Photos - Marchaell Surge, 1982a, se parametra de deservos
STORM HISTORY:			
SIONW (SISTOR).			