
City of Prince George HISTORY SHEET

P.I.D. 026 474 182 Legal: LOT 2 D.L. 4377 PLAN BCP20570 Address: 2402 McTAVISH ROAD Sanitary Connection: SIZE: 100mmø MATERIAL: PVC INV. 653.61m CONNECTED Water Connection: SIZE: INV. 655.50m 19mmø MATERIAL: COPPER METER Storm Connection: SIZE 100mmø MATERIAL PVC INV. 655.37m CONNECTED Cash Receipt No's: WATER SANITARY STORM CURB FROM PROPERTY LINE 5.0m PAVEMENT WIDTH 10.0m B.C. HYDRO 75mm DB2 U/G CONNECTION B.C. TELEPHONE 50mm DB2 U/G CONNECTION B.C. GAS 42 PROP/P.E. Information Sheets: REF. DWGS. L&M ENGINEERING LTD. JOB. 1253-01-03 DWGS. (001-305) CS CURB STOP Comments: THE INFORMATION CONTAINED HEREIN IS FOR INTERNAL USE ONLY.

NOT TO BE RELIED UPON UNLESS CONFIRMED BY THE SITE INSPECTION AND/OR INVESTIGATION

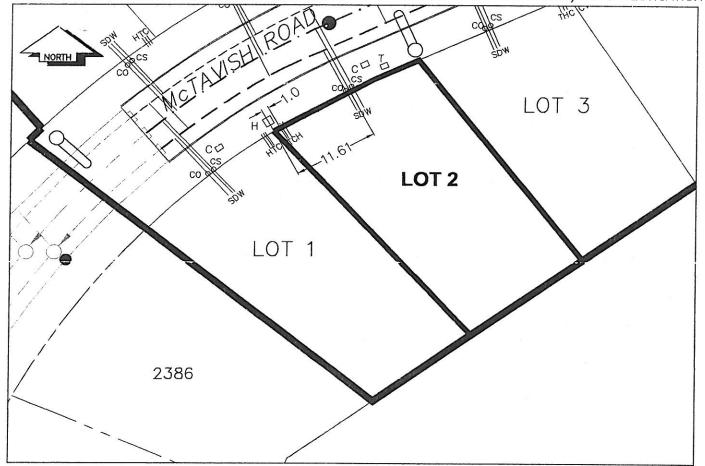

CANITADY CTORM & WATER SERVICE INVERTS	SANITARY	STORM	LOT 2 WATER
SANITARY, STORM & WATER SERVICE INVERTS		N/A	N/A
1. Distance from San. M.H. S-7 to connection point is 47.12 toward San. MH 514602	N/A		N/A
1a.Distance from Stm. M.H. D-8 to connection point is 49.82 toward Stm. MH 513603	200mmø	450mm∮	250mmø
2. Main Size at connection point is	653.28	655.04	655.17
3. Invert of main at conn. stub pt is	653.61	655.37	655.50
4. Invert at service end is	4.4m	3.5m	3.0m
5. Cut at P/I in meters 6. Survey Date AUGUST 20 05 Book Ref. 1253-01-03 by KILERIDE			
6. Survey Date AUGUST 20 05 Floak Ref. 1253-01-03 by KILBRIDE			
		-	

OWITABLY HISTORY			
SANITARY HISTORY:			
			and a supplemental supplemental supplement of the supplemental supplem
			· paranti anno paranti da san ya banda ana san
			water of the contract making the contract making the last the contract making the cont
			philanophicong cynolyddiadau genelenia the Allen dh
			MATSAT TO COMMUNICATION COMMUNICATION PROPERTY, 1917 AMERICAN CONTRACTOR APPROPRIEST OF
WATER HISTORY:			
			the last commenced and to the last of the
			d. Carillativity of the Campus relativity of the Campus and Additional Confession of the Campus and
			Andread to the control of the contro
STORM HISTORY,			AC 2000-00-00-00-00-00-00-00-00-00-00-00-00
	<u> </u>		