
City of Prince George

P.I.D. 026 474 204 D.L. 4377 PLAN BCP20570 Legal: LOT 4 2418 McTAVISH ROAD Address: MATERIAL: PVC INV. 654.47m CONNECTED Sanitary Connection: SIZE: 100mmø Water Connection: MATERIAL: COPPER INV. 655.16m **METER** SIZE: 19mmø Storm Connection: INV. 655.52m CONNECTED SIZE 100mmø MATERIAL PVC SANITARY STORM Cash Receipt No's: WATER PAVEMENT WIDTH 10.0m CURB FROM PROPERTY LINE 5.0m U/G CONNECTION 75mm DB2 B.C. HYDRO U/G CONNECTION B.C. TELEPHONE 50mm DB2 42 PROP/P.E. B.C. GAS---REF. DWGS. L&M ENGINEERING LTD. JOB. 1253-01-03 DWGS.(001-305) Information Sheets: Comments: CLEAN OUT

THE INFORMATION CONTAINED HEREIN IS FOR INTERNAL USE ONLY.

NOT TO BE RELIED UPON UNLESS CONFIRMED BY THE SITE INSPECTION AND/OR INVESTIGATION

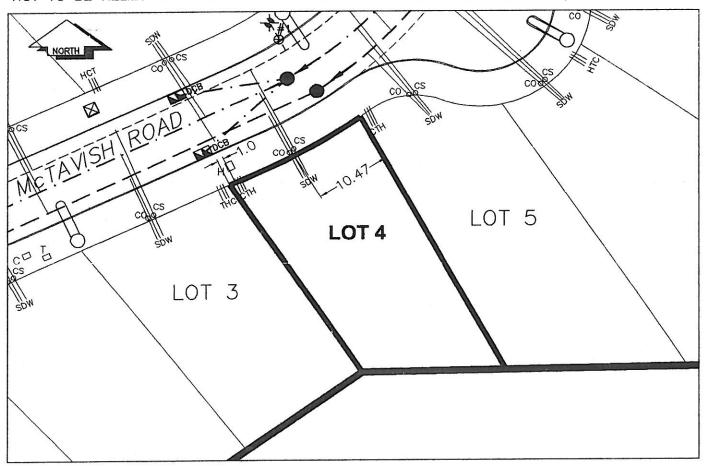

LOT 4

SANITARY, STORM & WATER SERVICE INVERTS	SANITARY	STORM	WATER 20.
i. Distance from San. MH S-7 to connection point is 89.21 toward San. MH 514602		N/A	N/A
1a.Distance from Stm. MH 543603 to connection point is 40.02 toward Stm. MH 514603	N/A		N/A
2. Main Size at connection point is	200mmø	450mmø	250mmø
3. Invert of main at conn. stub pt is	654.14	655.19	654.83
4. Invert at service end is	654.47	655.52	655.16
5. Cut at P/I in meters	3.2m	2.2m	2.5m
6. Survey Date AUGUST 20 05 Back Ref. 1253-01-03 by KILBRIDE			
d. Survey Butte 7,0000			
SANITARY HISTORY:			
JANUARI HISTORY.		10.00	The second of the same second
			4
		-	# * * * * * * * * * * * * * * * * * * *
WATER HISTORY:			
CTOP 4 MOTORY			
STORM HISTORY:			