

City of Prince George

HISTORY SHEET

P.I.D. 026 474 212

Legal: LOT 5

D.L. 4377

PLAN BCP20570

Address: 2426 McTAVISH ROAD

Sanitary Connection: SIZE: 100mm ϕ MATERIAL: PVC INV. 654.55m CONNECTED

Water Connection: SIZE: 19mm ϕ MATERIAL: COPPER INV. 655.26m METER

Storm Connection: SIZE 100mm ϕ MATERIAL PVC INV. 655.59m CONNECTED

Cash Receipt No's: WATER SANITARY STORM

CURB FROM PROPERTY LINE 5.0m PAVEMENT WIDTH 10.0m

B.C. HYDRO 75mm DB2 U/G CONNECTION ☒


B.C. TELEPHONE 50mm DB2 U/G CONNECTION ☒

B.C. GAS 42 PROP/P.E.

Information Sheets: REF. DWGS. L&M ENGINEERING LTD. JOB. 1253-01-03 DWGS.(001-305)

Comments: CS₀ CURB STOP SDW WATER SERVICE TOH HYDRO SERVICE
CO₀ CLEAN OUT SDW STORM SERVICE TOH CABLE SERVICE
SDW SANITARY SERVICE TOH TELECOMMUNICATIONS

- THE INFORMATION CONTAINED HEREIN IS FOR INTERNAL USE ONLY.
NOT TO BE RELIED UPON UNLESS CONFIRMED BY THE SITE INSPECTION AND/OR INVESTIGATION

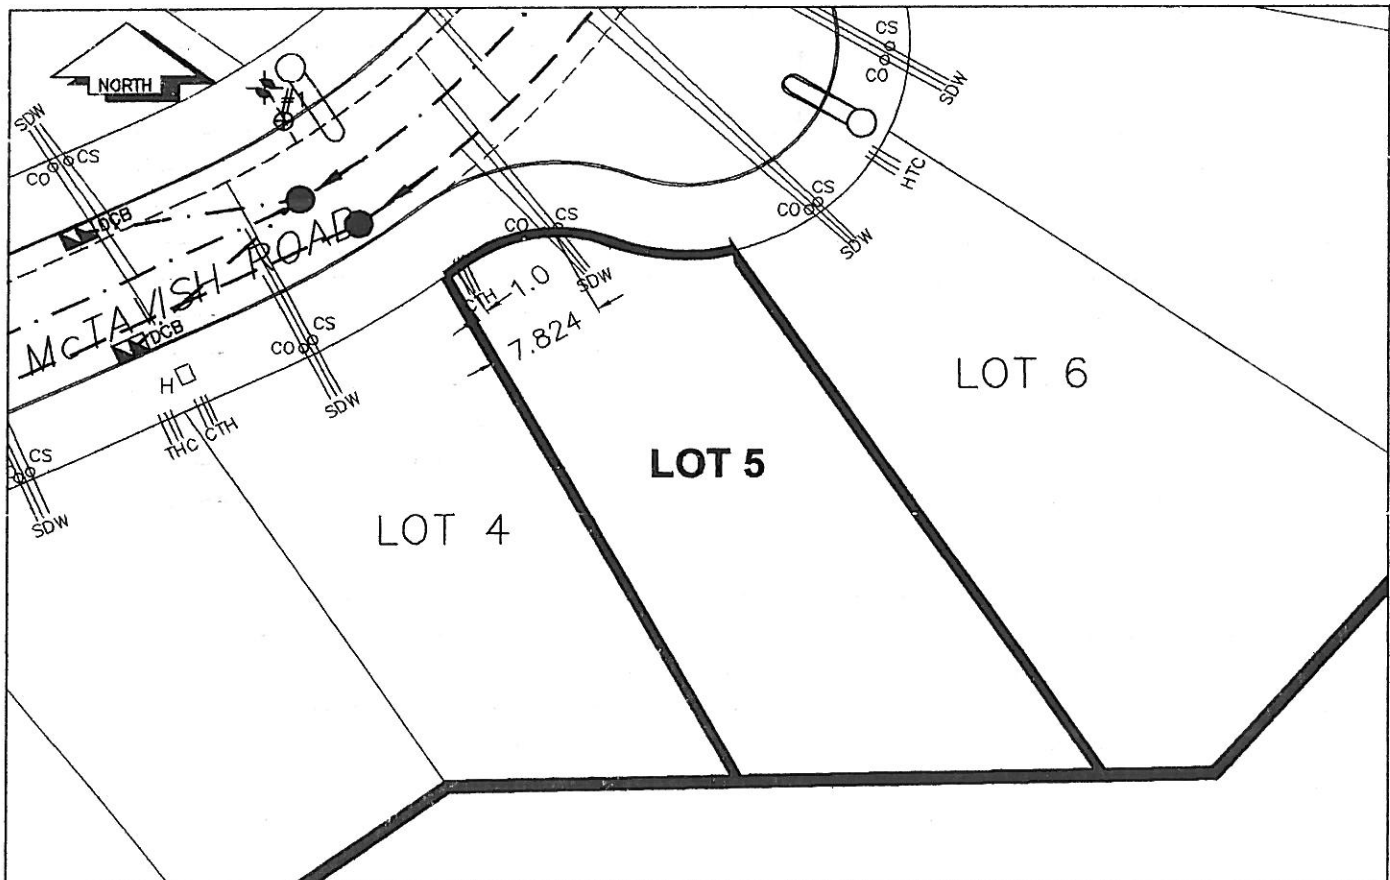

SANITARY HISTORY:

WATER HISTORY:

STORM HISTORY: