
City of Prince George HISTORY SHEET

Legal: LOT 7				D.L.	4377		PLAN BCP20570	
Address: 2442 McTAVISH RC	AD			1				
Sanitary Connection:	SIZE:	100mmø	MATERIAL:	PVC	INV.	654.97m	CONNECTED	
Water Connection:	SIZE:	19mmø	MATERIAL:	COPPER	INV.	655,62m	METER	
Storm Connection:	SIZE	100mmø	MATERIAL	PVC	INV.	655.88m	CONNECTED	
Cash Receipt No's:		WATER		SANITARY			STORM	
CURB FROM PROPERTY LINE 5.	0m		-			PAVEMEN	IT WIDTH 10.0m	
B.C. HYDRO 75mm DB2				U/G CONNECT	ION			
B.C. TELEPHONE 50mm DB2				U/G CONNECT	ION			
B.C. GAS 42 PROP/P.E.								
Information Sheets: REF.	DWGS.	L&M ENGINEERING						
Comments: CO CLEAN		——— ¥ WAT	ER SERVICE RM SERVICE ITARY SERVICE	₩	CABL	SERVICE SERVICE OMMUNICATION	MIC.	

THE INFORMATION CONTAINED HEREIN IS FOR INTERNAL USE ONLY.
NOT TO BE RELIED UPON UNLESS CONFIRMED BY THE SITE INSPECTION AND/OR INVESTIGATION

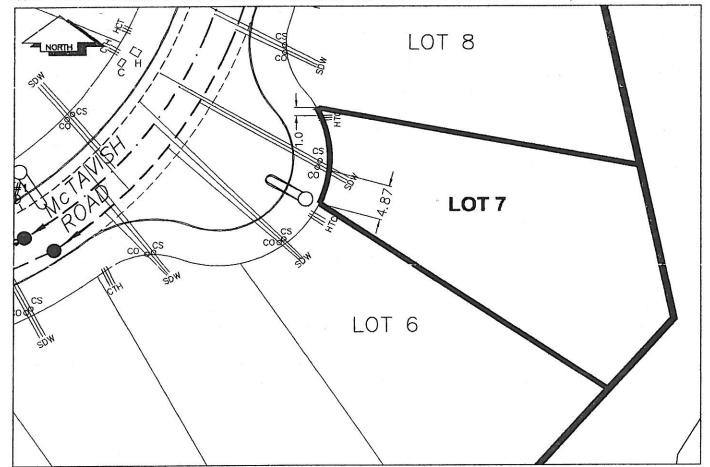

SANITARY, STORM & WATER SERVICE INVERTS	SANITARY	STORM	WATER
1. Distance from San. Mil 514602 to connection point is 27.13 toward San. MH 514601		N/A	N/A
1a.Distance from Stm. MH 514603 to connection point is 30.03 toward Stm. MH 514602	N/A		N/A
2. Main Size at connection point is	200mmø	300mmø	250mmø
3. Invert of main at conn. stub pt is	654.47	655.38	655.12
4. Invort at service end is	654.97	655.88	655.62
5. Cut at P/I ir. meters	3.1m	2.1m	2.4m
6. Survey Date AUGUST 20 05 Back Ref. 1253-C1-03 by KILBRIDE			
d. Survey back 7,00301. Ed.			
	, N		
SANITARY HISTORY:			892 12
ONITY THOUSE			
			in the state of th
			A THE SPRINGER SECTION AND SECURITY AND SECURITY SECTION SECTION AND SECURITY SECTION
		AND THE PERSON OF THE PERSON O	
			m access for annual of the constitution states of the Confession o
			A CONTRACTOR OF THE ACT
WATER HISTORY:			- Valoritation and Valo
			A
			. W. W. W. W. C.
STORM HISTORY:			
OTONIA FILOTONI.			