
City of Prince George HISTORY SHEET

P.I.D. 026 474 247 D.L. 4377 PLAN BCP20570 Legal: LOT 8 2450 McTAVISH ROAD Address: CONNECTED MATERIAL: PVC INV. 654.88m Sanitary Connection: SIZE: 100mmø MATERIAL: COPPER **METER** INV. 655.49m Water Connection: SIZE: 19mmø CONNECTED INV. 655.75m Storm Connection: MATERIAL PVC SIZE 100mmø SANITARY STORM Cash Receipt No's: WATER PAVEMENT WIDTH 10.0m CURB FROM PROPERTY LINE 5.0m U/G CONNECTION 75mm DB2 B.C. HYDRO U/G CONNECTION B.C. TELEPHONE 50mm DB2 B.C. GAS 42 PROP/P.E. Information Sheets: REF. DWGS. L&M ENGINEERING LTD. JOB. 1253-01-03 DWGS.(001-305) → WATER SERVICE → STORM SERVICE → SANITARY SERVICE CURB STOP Comments: CLEAN OUT

THE INFORMATION CONTAINED HEREIN IS FOR INTERNAL USE ONLY.
NOT TO BE RELIED UPON UNLESS CONFIRMED BY THE SITE INSPECTION AND/OR INVESTIGATION

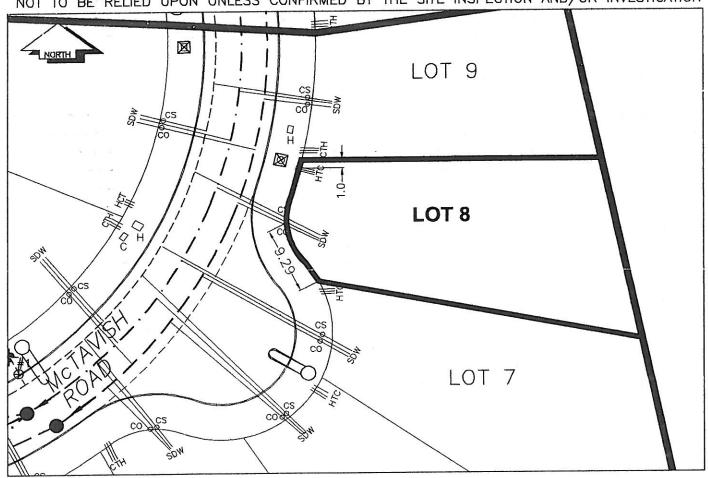

SANITARY, STORM & WATER SERVICE INVERTS	SANITARY	STORM	WATER
1. Distance from San. MH 514602 to connection point is 37.94 toward San. MH 514601		N/A	N/A
1a.Distance from Stm. MH 514603 to connection point is 41.35 toward Stm. MH 514602	N/A		N/A
2. Main Size at connection point is	200mmø	300rnmø	250mmø
3. Invert of main at conn. stub pt is	654.55	655.42	655.16
4. Invert at service end is	654.88	655.75	655.49
5. Cut at P/I in meters	3.3m	2.4m	2.6m
6. Survey Date AUGUST 20 05 Book Ref. 1253-01-03 by KILBRIDE			
	r name of the feature		
CANITADY INCTODY.			
SANITARY HISTORY:			
			and a successive succe
	watering the same transfer and t	A STATE OF THE PARTY OF THE PAR	
WATER HISTORY.			
WATER HISTORY:			
	and the same and t		
TORN HISTORY			
STORM HISTORY:			