



City of Prince George

HISTORY SHEET

PID:	026483319
SD/MU:	100447
WO:	

Civic Address: 1005 Eastern St.
Legal Description: Lot: B District Lot: 745 Plan: 17833


Service Type	Diameter (mm)	Material	Invert Elev at main (m)	Invert Elev at property line (m)	Invert Elev at service end (m)	Distance into property (m)	Installation Date
Sanitary	100mm	PVC	-	-	-	-	June 1979 & January 2024
Water	50mm	Copper	-	-	-	-	November 2005
Storm	N/A	N/A	-	-	-	-	-

Service Connection Location				Sanitary (m)	Storm (m)
Distance from downstream San MH	4145	towards upstream San MH	3562	48.10 & 64.80	-
Distance from downstream Strm MH	-	towards upstream Strm MH	-	-	-

Power	Size	Communications	Size	Cable	Size	Gas	Size
BC Hydro	-	Telus	-	Shaw	-	FortisBC	-
Underground Service		Underground Service		Underground Service		Underground Service	

Installed by:	Survey Date:	-
Comments: Service locations confirmed September 2016		

NOT TO SCALE. The information contained herein is for internal use only.
Not to be relied on unless confirmed by site inspection and/or investigation.

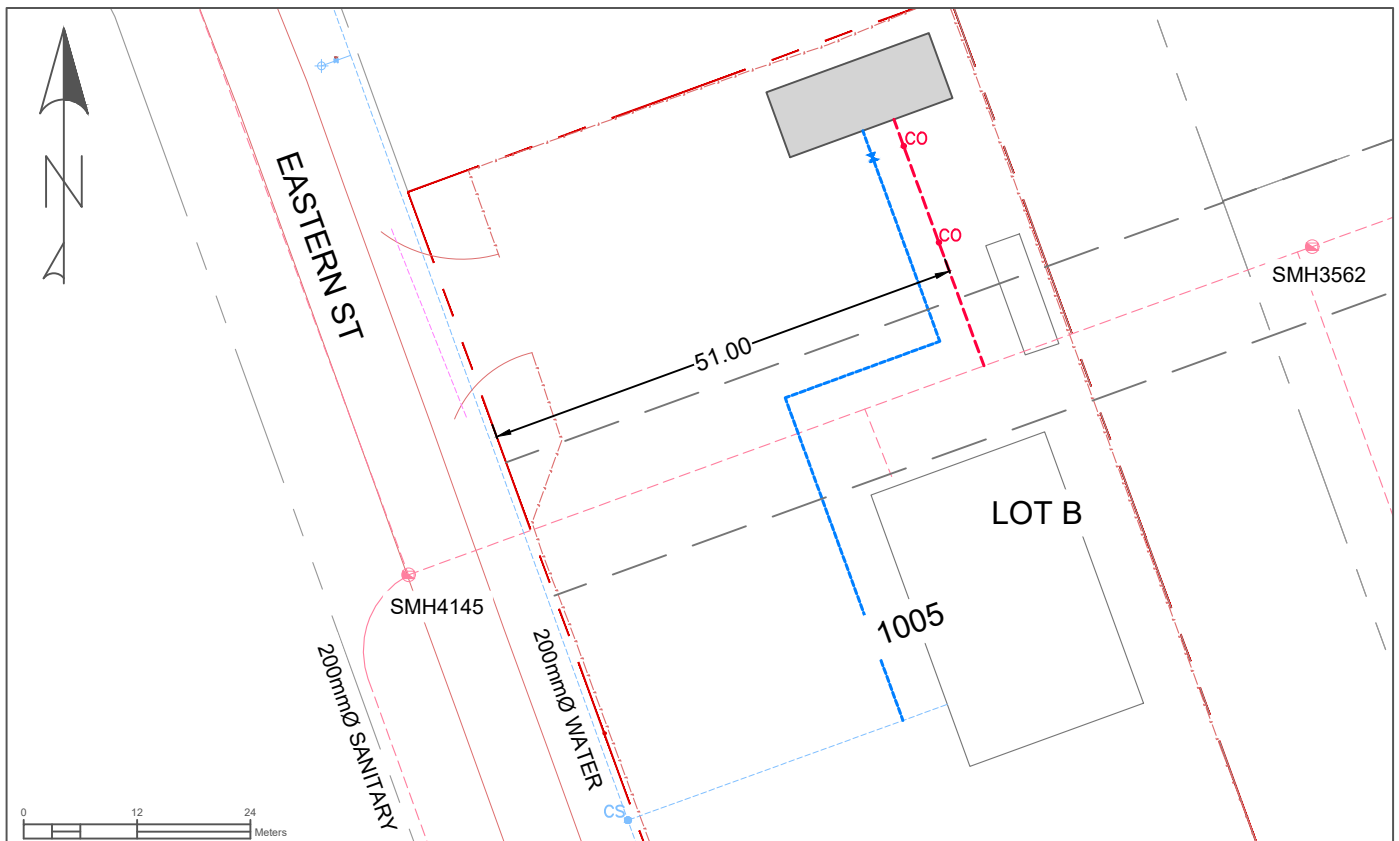

LEGEND:

CS	CURB STOP	---	WATER SERVICE	---	STORM SERVICE
CO	CLEAN OUT	---	SANITARY SERVICE	---	GAS