


## Lot Servicing

3820 HILLCREST RD

PID: 026495180

**Lot:** B, **Plan:** BCP20932, **DL:** 2003

SERVICE	SIZE	MATERIAL	INSTALLED DATE	LOCATION	DETAILS
WATER	20MM	CU	26-Sep-2007	6.0M E OF W PL	CASH RECEIPT NUMBER 100437
SANITARY	100MM	PVC	26-Sep-2007	6.0M E OF W PL	CLEANOUT 6.0M E OF W PL

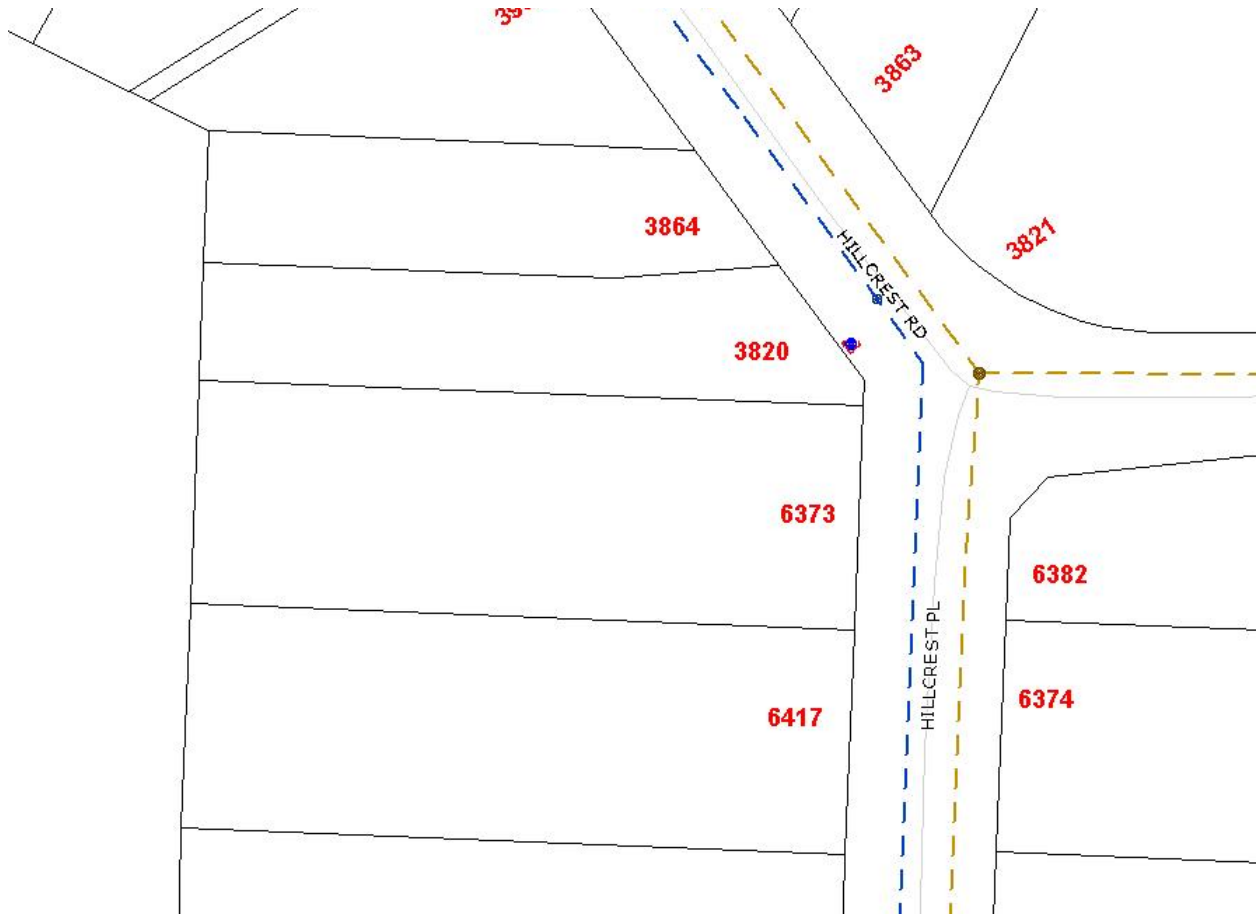

Accuracy not guaranteed unless confirmed by site inspection and/or investigation.  
Connection location between main and property line only.