



City of Prince George
History Sheet

PID:	026651947
SD/MU:	100043/101104
WO:	54611/54613

Civic Address: 2410 Laurier Cres


Legal Description: Lot: A (BA369576) District Lot: 343 Plan: 34806

Service Type	Diameter (mm)	Material	Invert Elev at main (m)	Depth of cut at property line (m)	Invert Elev at service end (m)	Distance into property (m)	Installation Date
Sanitary (1)	150mm	PVC	-	1.45	586.14	-	-
Sanitary (2)	150mm	PVC	-	2.86	585.43	-	-
Sanitary (3)	150mm	PVC	-	2.50	-	-	January 2000
Water (1)	100mm	PVC	-	-	-	-	-
Water (2)	150mm	PVC	-	-	-	-	-
Water (3)	150mm	PVC	-	-	-	-	-
Water (4)	150mm	PVC	-	-	-	-	-
Storm	200mm	PVC	-	-	-	-	-

Power	Size	Communications	Size	Cable	Size	Gas	Size
BC Hydro	-	Telus	-	Shaw	-	FortisBC	-
Overhead Service		Overhead Service		Overhead Service			

Installed by:	Survey Date:	-
Comments:		

NOT TO SCALE The information contained herein is for internal use only.
Not to be relied on unless confirmed by site inspection and/or investigation.

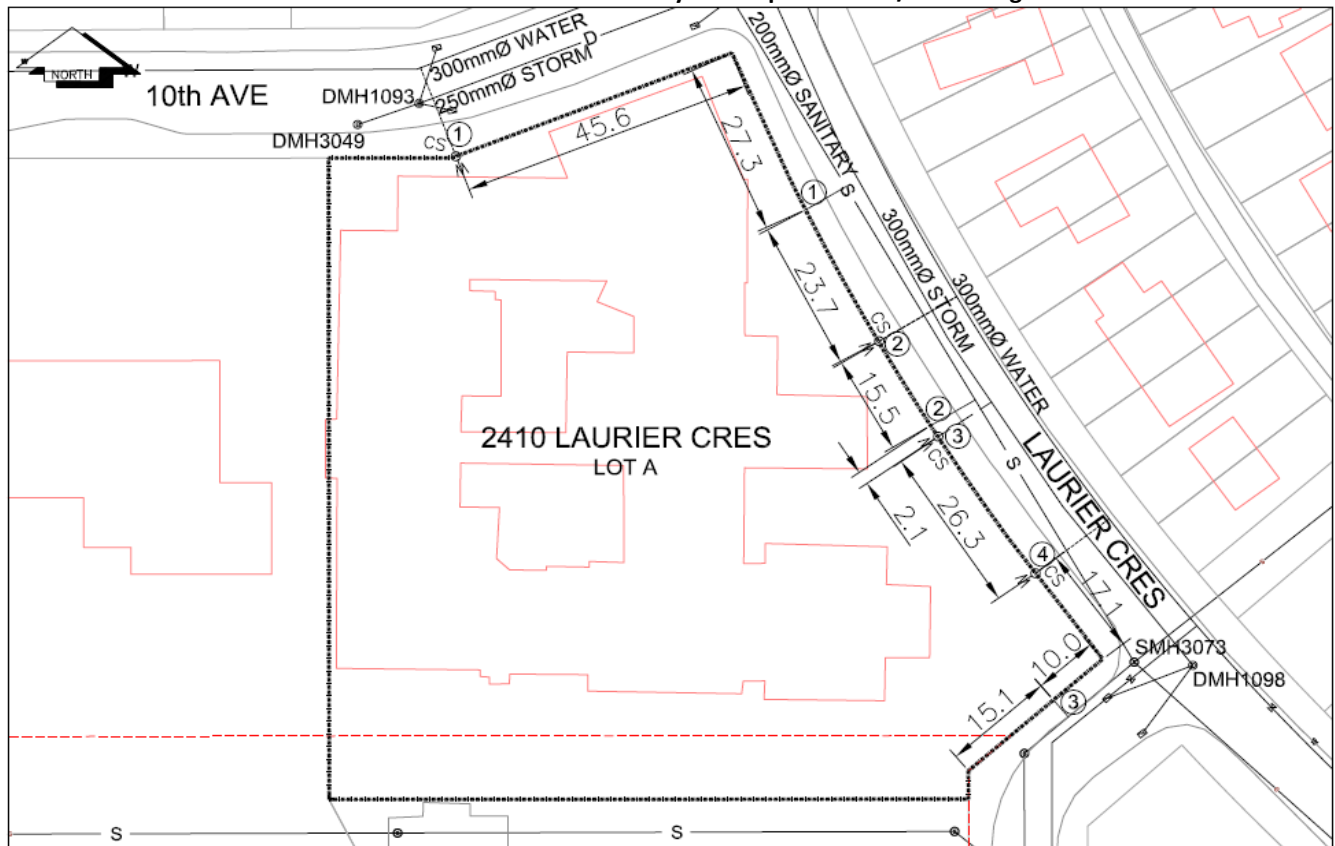

LEGEND:	CS ^o CURB STOP	--- WATER SERVICE	--- STORM SERVICE
	CO ^o CLEAN OUT	--- SANITARY SERVICE	⊗ WATER VALVE

NOT TO SCALE