

City of Prince George

HISTORY SHEET

P.I.D. 026666782

Legal: LOT 1

D.L. 482

PLAN BCP23670

Address: 4774 HILL AVENUE

SCALE: 1:500

Sanitary Connection: SIZE: 100mm \emptyset MATERIAL: PVC INV. 604.21m CONNECTED

Storm Connection: N/A

Water Connection: SIZE 19mm \emptyset MATERIAL COPPER INV. 604.11m METER

Cash Receipt No's: WATER SANITARY STORM

CURB FROM PROPERTY LINE 4.25m PAVEMENT WIDTH 12.8m

B.C. HYDRO 75mm DB2 U/G CONNECTION ✓


TELUS 50mm DB2 U/G CONNECTION ✓

TERASEN 42 PROP/P.E. U/G CONNECTION ✓

Information Sheets: REF. DWGS. L&M ENGINEERING LTD. JOB. 1264-01-02 DWGS.(001-306)

Comments: CS_o CURB STOP ———> WATER SERVICE ———+ HYDRO SERVICE
CO_o CLEAN OUT ———S SANITARY SERVICE ———+ CABLE SERVICE
TELECOMMUNICATIONS

THE INFORMATION CONTAINED HEREIN IS FOR INTERNAL USE ONLY.
NOT TO BE RELIED UPON UNLESS CONFIRMED BY THE SITE INSPECTION AND/OR INVESTIGATION

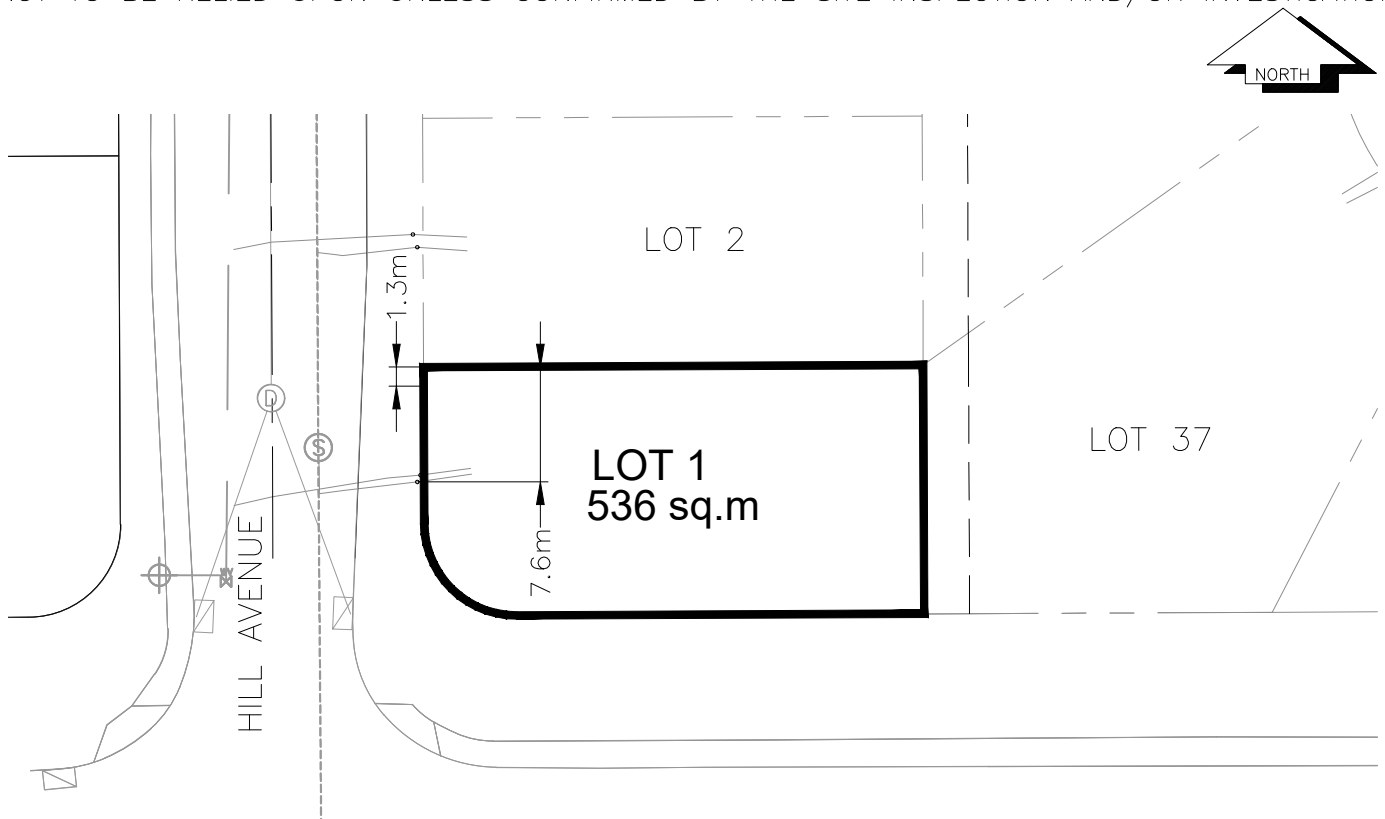

[illegible][illegible][illegible]