
City of Prince George HISTORY SHEET

P.I.D. 026666804			
Legal: LOT 3		D.L. 482	PLAN BCP23670
Address: 4728 HILL AVENUE			SCALE: 1:500
Sanitary Connection: SIZE:	100mmø MATERIAL:	PVC INV.	604.51m CONNECTED
Storm Connection:	N/A		
Water Connection: SIZE	19mmø MATERIAL	COPPER INV.	604.37m METER
Cash Receipt No's:	WATER	SANITARY	STORM
CURB FROM PROPERTY LINE 3.73m			PAVEMENT WIDTH 12.7
B.C. HYDRO 75mm DB2		U/G CONNECTION	<u> </u>
TELUS 50mm DB2		U/G CONNECTION	<u> </u>
TERASEN 42 PROP/P.E.		U/G CONNECTION	<u> </u>
Information Sheets: REF. DWGS.	L&M ENGINEERING LTD. JOB	. 1264-01-02 DWGS	S.(001–306)
Comments: CS CURB STOP COO CLEAN OUT	———> WATER SERVICE ——— SANITARY SERVI	□ ± HYDR CABLE TELEC	O SERVICE E SERVICE COMMUNICATIONS

THE INFORMATION CONTAINED HEREIN IS FOR INTERNAL USE ONLY.
NOT TO BE RELIED UPON UNLESS CONFIRMED BY THE SITE INSPECTION AND/OR INVESTIGATION

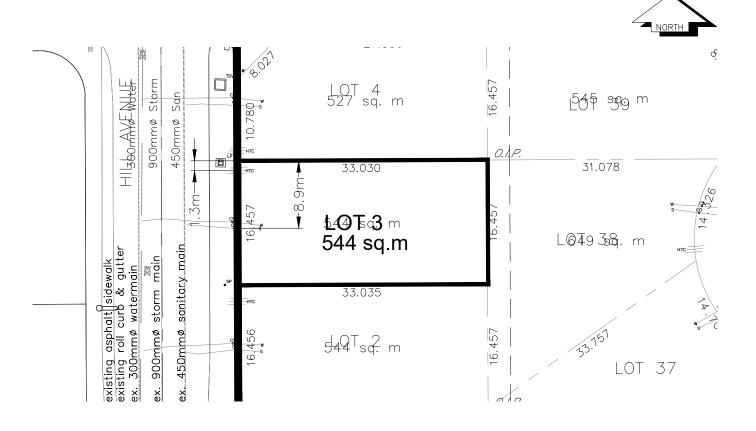

SANITARY, STORM & WATER SERVICE INVERTS	SANITARY	STORM	WATER
Distance from S.M.H. FM63G to connection point toward S.M.H. FM63B	59.60m	N/A	N/A
2. Main Size at connection point is	450mmø	_	300mmø
3. Invert of main at conn. stub pt is	602.45	_	603.11
4. Invert at service end is	604.41	_	604.37
5. Cut at P/I in meters	2.55m	-	2.62m
6. Survey Date AUGUST 20 06 Book Ref. 1264-01-02 by FORESIGHT			
SANITARY HISTORY:			
WATER HISTORY:			
STORM HISTORY:			