
City of Prince George HISTORY SHEET

P.I.D. 026666839					
Legal: LOT 6		D.L. 482	PLAN BCP23670	PLAN BCP23670	
Address: 4668 HILL AVENUE			SCALE: 1:500		
Sanitary Connection: SIZE: 1	100mmø MATERIAL:	PVC INV.	605.19m CONNECTED		
Storm Connection:	N/A				
Water Connection: SIZE 1	19mmø MATERIAL	COPPER INV.	605.06m METER		
Cash Receipt No's:	WATER	SANITARY	STORM		
CURB FROM PROPERTY LINE 3.76m			PAVEMENT WIDTH 12.79m		
B.C. HYDRO 75mm DB2		U/G CONNECTION	/		
TELUS 50mm DB2		U/G CONNECTION	/		
TERASEN 42 PROP/P.E.		U/G CONNECTION	/		
Information Sheets: REF. DWGS. La	&M ENGINEERING LTD. JOB.	. 1264-01-02 DWGS	5.(001–306)		
Comments: CS CURB STOP COO CLEAN OUT	———> WATER SERVICE ——∽ SANITARY SERVI	— HYDR(CABLE TELEC	O SERVICE E SERVICE COMMUNICATIONS		

THE INFORMATION CONTAINED HEREIN IS FOR INTERNAL USE ONLY.
NOT TO BE RELIED UPON UNLESS CONFIRMED BY THE SITE INSPECTION AND/OR INVESTIGATION

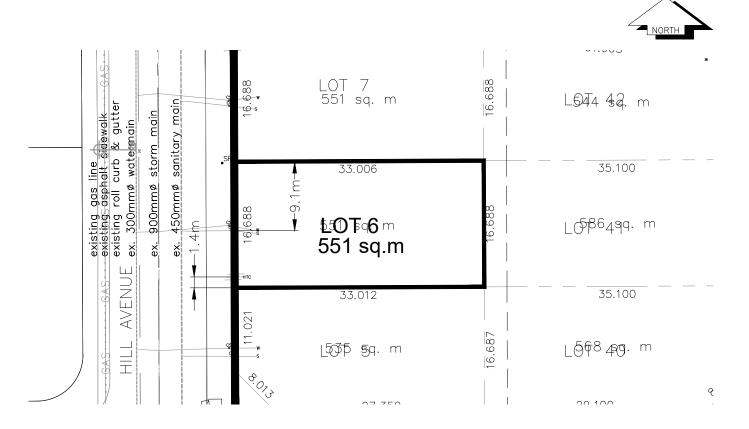

SANITARY, STORM & WATER SERVICE INVERTS	SANITARY	STORM	WATER
1. Distance from S.M.H. FM63B to connection point toward S.M.H. FM64B	71.56m	N/A	N/A
2. Main Size at connection point is	450mmø	_	300mmø
3. Invert of main at conn. stub pt is	602.60	_	603.98
4. Invert at service end is	605.09	_	605.06
5. Cut at P/I in meters	2.62m	_	2.47m
6. Survey Date AUGUST 20 06 Book Ref. 1264-01-02 by FORESIGHT			
o. durvoy batto me ever 20 do book not. Here by here every			
SANITARY HISTORY:			
WATER LUCTORY			
WATER HISTORY:			
STORM HISTORY:			