
## City of Prince George HISTORY SHEET

P.I.D. 026666847				
Legal: LOT 7		D.L. 482		PLAN BCP23670
Address: 4642 HILL AVENUE			SCALE:	1:500
Sanitary Connection: SIZE: 1	100mmø MATERIAL:	PVC INV.	605.19m	CONNECTED
Storm Connection:	N/A			
Water Connection: SIZE 1	19mmø MATERIAL	COPPER INV.	605.07m	METER
Cash Receipt No's:	WATER	SANITARY		STORM
CURB FROM PROPERTY LINE 3.76m			PAVEMEN	T WIDTH 12.77m
B.C. HYDRO 75mm DB2		U/G CONNECTION	/	
TELUS 50mm DB2		U/G CONNECTION	/	
TERASEN 42 PROP/P.E.		U/G CONNECTION	/	
Information Sheets: REF. DWGS. La	&M ENGINEERING LTD. JOB.	1264-01-02 DWGS	S.(001–306)	
Comments: CS CURB STOP COO CLEAN OUT	———> WATER SERVICE ——∽ SANITARY SERVIC	—   HYDR  CABLE  TELEC	O SERVICE E SERVICE COMMUNICATIO	NS

THE INFORMATION CONTAINED HEREIN IS FOR INTERNAL USE ONLY.
NOT TO BE RELIED UPON UNLESS CONFIRMED BY THE SITE INSPECTION AND/OR INVESTIGATION

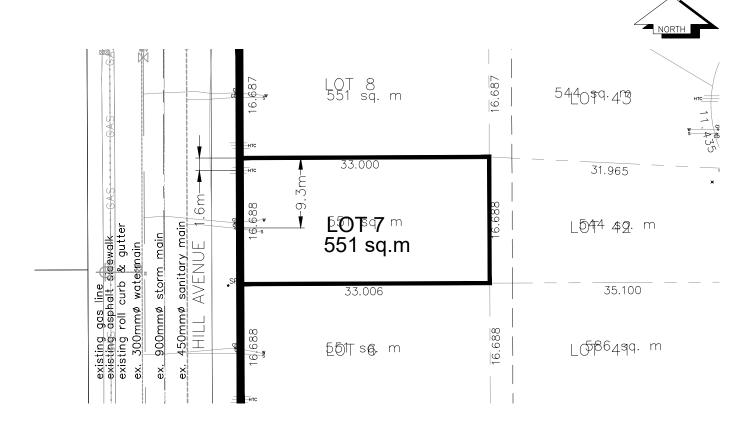

SANITARY, STORM & WATER SERVICE INVERTS	SANITARY	STORM	WATER
1. Distance from S.M.H. FM63B to connection point toward S.M.H. FM64B	105.69m	N/A	N/A
2. Main Size at connection point is	450mmø	_	300mmø
3. Invert of main at conn. stub pt is	602.64	_	604.15
4. Invert at service end is	605.09	_	605.07
5. Cut at P/I in meters	2.77m	_	2.74m
6. Survey Date AUGUST 20 06 Book Ref. 1264-01-02 by FORESIGHT			
5. Survey Botto 11.12.12.12. 25 25 Bott 116.11			
SANITARY HISTORY:			
- ANTAKT HISTOKI.			
WATER HISTORY:			
STORM HISTORY:			