
City of Prince George HISTORY SHEET

P.I.D. 026666898				
Legal: LOT 12	D.L. 4	482 PLAN BCP23670		
Address: 4543 HILL AVENUE		SCALE: 1:500		
Sanitary Connection: SIZE: 100mmø	MATERIAL: PVC	INV. 604.82m CONNECTED		
Storm Connection: N/A				
Water Connection: SIZE 19mmø	MATERIAL COPPER	INV. 604.74m METER		
Cash Receipt No's: WATER	SANITARY	STORM		
CURB FROM PROPERTY LINE 4.61m		PAVEMENT WIDTH 13.26m		
B.C. HYDRO 75mm DB2	U/G CONNECTION	ON /		
TELUS 50mm DB2	U/G CONNECTION	ON /		
TERASEN 42 PROP/P.E.	U/G CONNECTION	ON /		
Information Sheets: REF. DWGS. L&M ENGINEERING LTD. JOB. 1264-01-02 DWGS.(001-306)				
CS CURB STOP —>> WATE COMments: CS CURB STOP —>> WATE —> SANI	<u>—</u>	HYDRO SERVICE CABLE SERVICE TELECOMMUNICATIONS		

THE INFORMATION CONTAINED HEREIN IS FOR INTERNAL USE ONLY.
NOT TO BE RELIED UPON UNLESS CONFIRMED BY THE SITE INSPECTION AND/OR INVESTIGATION

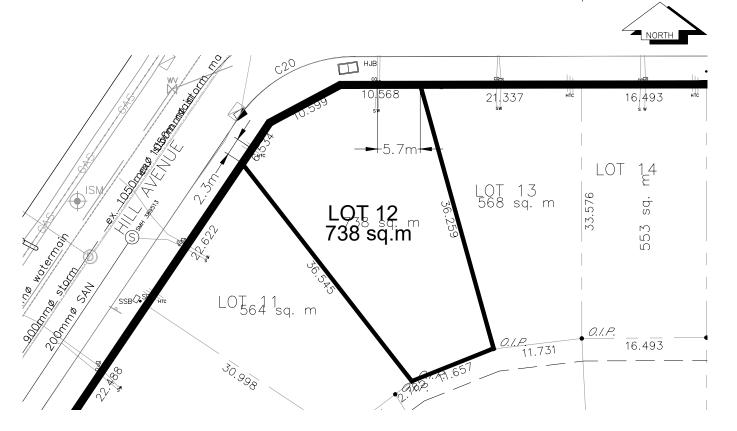

SANITARY, STORM & WATER SERVICE INVERTS	SANITARY	STORM	WATER
1. Distance from S.M.H. 389514 to connection point toward S.M.H. 389514	0.0m	N/A	N/A
2. Main Size at connection point is	200mmø	_	200mmø
3. Invert of main at conn. stub pt is	604.20	_	603.99
4. Invert at service end is	604.72	_	604.74
5. Cut at P/I in meters	2.43m	_	2.42m
6. Survey Date AUGUST 20 06 Book Ref. 1264-01-02 by FORESIGHT			
<u> </u>			
SANITARY HISTORY:			
SANTANT HISTONY.			
WATER HISTORY:			
STORM HISTORY:			