
## City of Prince George HISTORY SHEET

P.I.D. 026666910							
_egal: LOT 14			D.L.	482	P	PLAN BCP23670	
Address: 4505 HILL AVENUE		SCALE: 1:500				00	
Sanitary Connection: SIZE:	100mmø	MATERIAL:	PVC	INV.	604.67m	CONNECTED	
Storm Connection:	N/A						
Water Connection: SIZE	19mmø	MATERIAL	COPPER	INV.	604.55m	METER	
Cash Receipt No's:	WATER		SANITARY			STORM	
CURB FROM PROPERTY LINE 3.77m					PAVEMENT	WIDTH 12.73m	
B.C. HYDRO 75mm DB2			U/G CONNECT	ION			
TELUS 50mm DB2			U/G CONNECT	ION	/		
TERASEN 42 PROP/P.E.			U/G CONNECT	ION			
Information Sheets: REF. DWGS.	L&M ENGINEERING	LTD. JOB	. 1264-01-02	DWGS	S.(001–306)		
Comments: CS CURB STOP COO CLEAN OUT	-	ER SERVICE ITARY SERVI	CE =	HYDR CABLE TELEC	O SERVICE E SERVICE COMMUNICATION	S	

THE INFORMATION CONTAINED HEREIN IS FOR INTERNAL USE ONLY.
NOT TO BE RELIED UPON UNLESS CONFIRMED BY THE SITE INSPECTION AND/OR INVESTIGATION

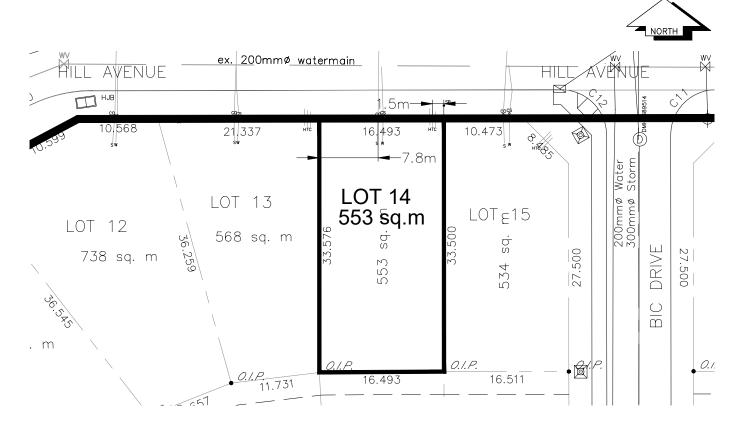

SANITARY, STORM & WATER SERVICE INVERTS	SANITARY	STORM	WATER
1. Distance from S.M.H. 389514 to connection point toward S.M.H. 389515	13.91m	N/A	N/A
2. Main Size at connection point is	200mmø	_	200mmø
3. Invert of main at conn. stub pt is	604.13	_	603.14
4. Invert at service end is	604.65	_	604.66
5. Cut at P/I in meters	2.04m	_	2.05m
6. Survey Date AUGUST 20 06 Book Ref. 1264-01-02 by FORESIGHT			
<u> </u>			
SANITARY HISTORY:			
SANTANT HISTONI.			
WATER HISTORY:			
STORM HISTORY:			