
City of Prince George HISTORY SHEET

P.I.D. 026666928				
Legal: LOT 15		D.L. 482	PLAN B	3CP23670
Address: 4481 HILL AVENUE			SCALE: 1:500	
Sanitary Connection: SIZE:	100mmø MATERIAL:	PVC INV.	604.67m CC	DNNECTED
Storm Connection:	N/A			
Water Connection: SIZE	19mmø MATERIAL	COPPER INV.	604.37m ME	ITER
Cash Receipt No's:	WATER	SANITARY	STORM	1
CURB FROM PROPERTY LINE 3.77m			PAVEMENT WIDTH	H 12.73m
B.C. HYDRO 75mm DB2		U/G CONNECTION		
TELUS 50mm DB2		U/G CONNECTION	/	
TERASEN 42 PROP/P.E.		U/G CONNECTION	<u> </u>	
Information Sheets: REF. DWGS. L	.&M ENGINEERING LTD. JOB	. 1264-01-02 DWGS	S.(001–306)	
Comments: CS CURB STOP COO CLEAN OUT	———≫ WATER SERVICE ——— SANITARY SERVI	CE HYDR CABLI	O SERVICE E SERVICE COMMUNICATIONS	

THE INFORMATION CONTAINED HEREIN IS FOR INTERNAL USE ONLY.
NOT TO BE RELIED UPON UNLESS CONFIRMED BY THE SITE INSPECTION AND/OR INVESTIGATION

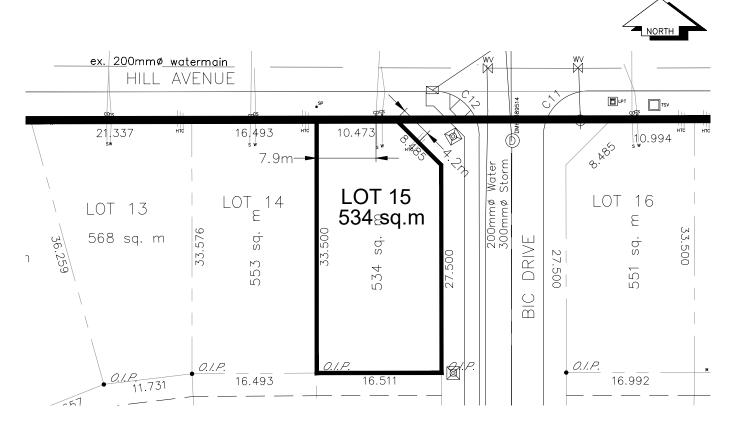

SANITARY, STORM & WATER SERVICE INVERTS	SANITARY	STORM	WATER
1. Distance from S.M.H. 389514 to connection point toward S.M.H.389515	19.59m	N/A	N/A
·			
2. Main Size at connection point is	200mmø	_	200mmø
3. Invert of main at conn. stub pt is	604.07	_	602.98
4. Invert at service end is	604.67	_	604.37
5. Cut at P/I in meters	1.80m	_	2.10m
6. Survey Date AUGUST 20 06 Book Ref. 1264-01-02 by FORESIGHT			
6. Survey Bute 1100001 20 00 Book Not. 120 01 02 by 121120121			
SANITARY HISTORY:			
WATER LUCTORY			
WATER HISTORY:			
CTORY HISTORY			
STORM HISTORY:			