
City of Prince George HISTORY SHEET

P.I.D. 026666936					
Legal: LOT 16		D.L. 482	PLA	AN BCP23670	
Address: 4473 HILL AVENUE			SCALE: 1:500		
Sanitary Connection: SIZE:	100mmø MATERIA	L: PVC INV.	604.44m	CONNECTED	
Storm Connection:	N/A				
Water Connection: SIZE	19mmø MATERIA	L COPPER INV.	604.22m	METER	
Cash Receipt No's:	WATER	SANITARY	Sī	TORM	
CURB FROM PROPERTY LINE 5.0m			PAVEMENT V	VIDTH 10.0m	
B.C. HYDRO 75mm DB2		U/G CONNECTION			
TELUS 50mm DB2		U/G CONNECTION	/		
TERASEN 42 PROP/P.E.		U/G CONNECTION	<u> </u>		
Information Sheets: REF. DWGS.	L&M ENGINEERING LTD. J	DB. 1264-01-02 DWG	S.(001-306)		
Comments: CS CURB STOP COO CLEAN OUT	———> WATER SERVI ——─── SANITARY SE	— ∴ CABI	RO SERVICE LE SERVICE COMMUNICATIONS		

THE INFORMATION CONTAINED HEREIN IS FOR INTERNAL USE ONLY.
NOT TO BE RELIED UPON UNLESS CONFIRMED BY THE SITE INSPECTION AND/OR INVESTIGATION

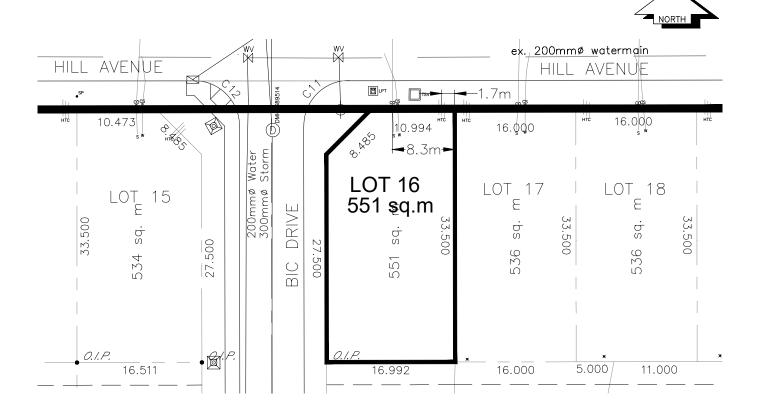

SANITARY, STORM & WATER SERVICE INVERTS	SANITARY	STORM	WATER
1. Distance from S.M.H. 389515 to connection point toward S.M.H. FM74A	12.65m	N/A	N/A
2. Main Size at connection point is	200mmø	_	200mmø
3. Invert of main at conn. stub pt is	603.90	_	602.91
4. Invert at service end is	604.44	_	604.22
5. Cut at P/I in meters	1.86m	_	2.10m
6. Survey Date AUGUST 20 06 Book Ref. 1264-01-02 by FORESIGHT			
o. Survey Bute 7,00031 20 00 Book Net. 1201 01 02 by 1 on 20101			
SANITARY HISTORY:			
WATER HISTORY:			
STORM HISTORY:			