

# City of Prince George

## HISTORY SHEET

P.I.D. 026666944

Legal: LOT 17

D.L. 482

PLAN BCP23670

Address: 4451 HILL AVENUE

SCALE: 1:500

Sanitary Connection: SIZE: 100mm $\phi$  MATERIAL: PVC INV. 604.34m CONNECTED

Storm Connection: N/A

Water Connection: SIZE 19mm $\phi$  MATERIAL COPPER INV. 604.10m METER

Cash Receipt No's: WATER SANITARY STORM

CURB FROM PROPERTY LINE 3.77m PAVEMENT WIDTH 12.73m

B.C. HYDRO 75mm DB2 U/G CONNECTION ☒


TELUS 50mm DB2 U/G CONNECTION ☒

TERASEN 42 PROP/P.E. U/G CONNECTION ☒

Information Sheets: REF. DWGS. L&M ENGINEERING LTD. JOB. 1264-01-02 DWGS.(001-306)

Comments:  $\text{CS}_0$  CURB STOP  $\text{CO}_0$  CLEAN OUT  $\text{---}\text{>}$  WATER SERVICE  $\text{---}\text{S}$  SANITARY SERVICE  $\text{---}\text{H}$  HYDRO SERVICE  $\text{---}\text{C}$  CABLE SERVICE  $\text{---}\text{F}$  TELECOMMUNICATIONS

THE INFORMATION CONTAINED HEREIN IS FOR INTERNAL USE ONLY.  
NOT TO BE RELIED UPON UNLESS CONFIRMED BY THE SITE INSPECTION AND/OR INVESTIGATION

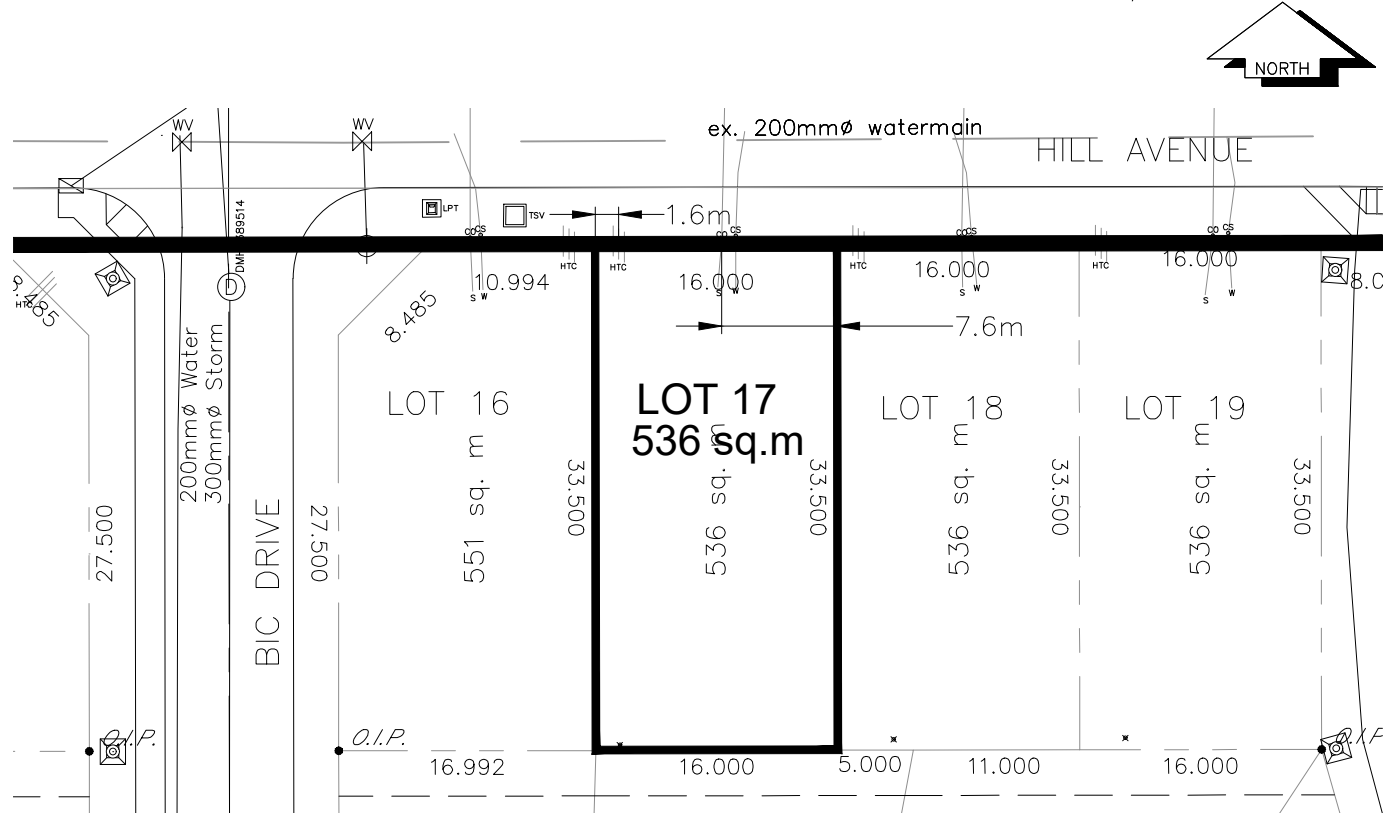

[illegible][illegible][illegible]