

City of Prince George

HISTORY SHEET

P.I.D. 026666979

Legal: LOT 20

D.L. 482

PLAN BCP23670 REM

Address: 415 TARA PL

SCALE: 1:500

Sanitary Connection: SIZE: 100mm \emptyset MATERIAL: PVC INV. m CONNECTED

Storm Connection: N/A

Water Connection: SIZE 19mm \emptyset MATERIAL COPPER INV. m METER

Cash Receipt No's: WATER SANITARY STORM

CURB FROM PROPERTY LINE 5.0m PAVEMENT WIDTH 12.0m

B.C. HYDRO 75mm DB2 U/G CONNECTION ✓


TELUS 50mm DB2 U/G CONNECTION ✓

TERASEN 42 PROP/P.E. U/G CONNECTION ✓

Information Sheets: REF. DWGS. L&M ENGINEERING LTD. JOB. 1264-01-02 DWGS.(001-306)

Comments: CS₀ CURB STOP ———> WATER SERVICE ———+— HYDRO SERVICE
CO₀ CLEAN OUT ———S— SANITARY SERVICE ———+— CABLE SERVICE
TELECOMMUNICATIONS

THE INFORMATION CONTAINED HEREIN IS FOR INTERNAL USE ONLY.
NOT TO BE RELIED UPON UNLESS CONFIRMED BY THE SITE INSPECTION AND/OR INVESTIGATION

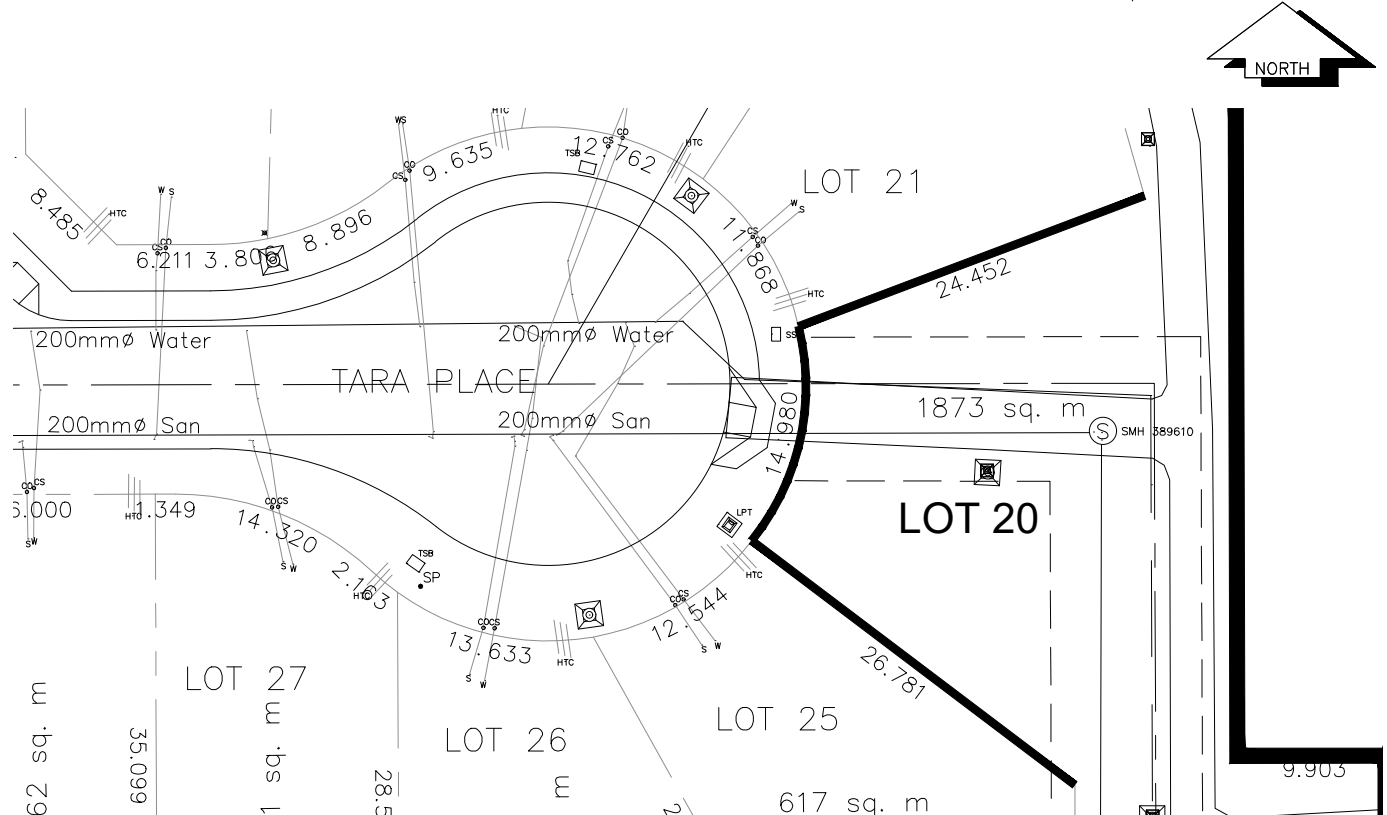

SANITARY, STORM & WATER SERVICE INVERTS	SANITARY	STORM	WATER
—	N/A	N/A	N/A
2. Main Size at connection point is	—	—	—
3. Invert of main at conn. stub pt is	—	—	—
4. Invert at service end is	—	—	—
5. Cut at P/I in meters	—	—	—
6. Survey Date AUGUST 20 06 Book Ref. 1264—01—02 by FORESIGHT			

SANITARY HISTORY:

WATER HISTORY:

STORM HISTORY:
