



City of Prince George History Sheet

PID:	026670691
MU:	100041
WO:	00-P0016

Civic Address: 1745 Boundary Rd
1765 Boundary Rd

Legal Description: Lot: PCL 1 Block: 52 District Lot: 629 Plan: BCP23797


Service Type	Diameter (mm)	Material	Invert Elev at main (m)	Invert Elev at property line (m)	Invert Elev at service end (m)	Distance into property (m)	Installation Date
Sanitary	100mm	PVC	-	-	-	-	September 2000
Water	50mm	Copper	-	-	-	-	September 2000
Storm	N/A	N/A	-	-	-	-	-

Service Connection Location				Sanitary (m)	Storm (m)
Distance from downstream San MH	2885	towards upstream San MH	3416	70.60	
Distance from downstream Stm MH	-	towards upstream Stm MH	-		

Power	Size	Communications	Size	Cable	Size	Gas	Size
BC Hydro	-	Telus	-	Shaw	-	FortisBC	-
Overhead Service		Overhead Service		Overhead Service			

Installed by:	City of Prince George forces	Survey Date:	-
Comments:			

NOT TO SCALE The information contained herein is for internal use only.
Not to be relied on unless confirmed by site inspection and/or investigation.

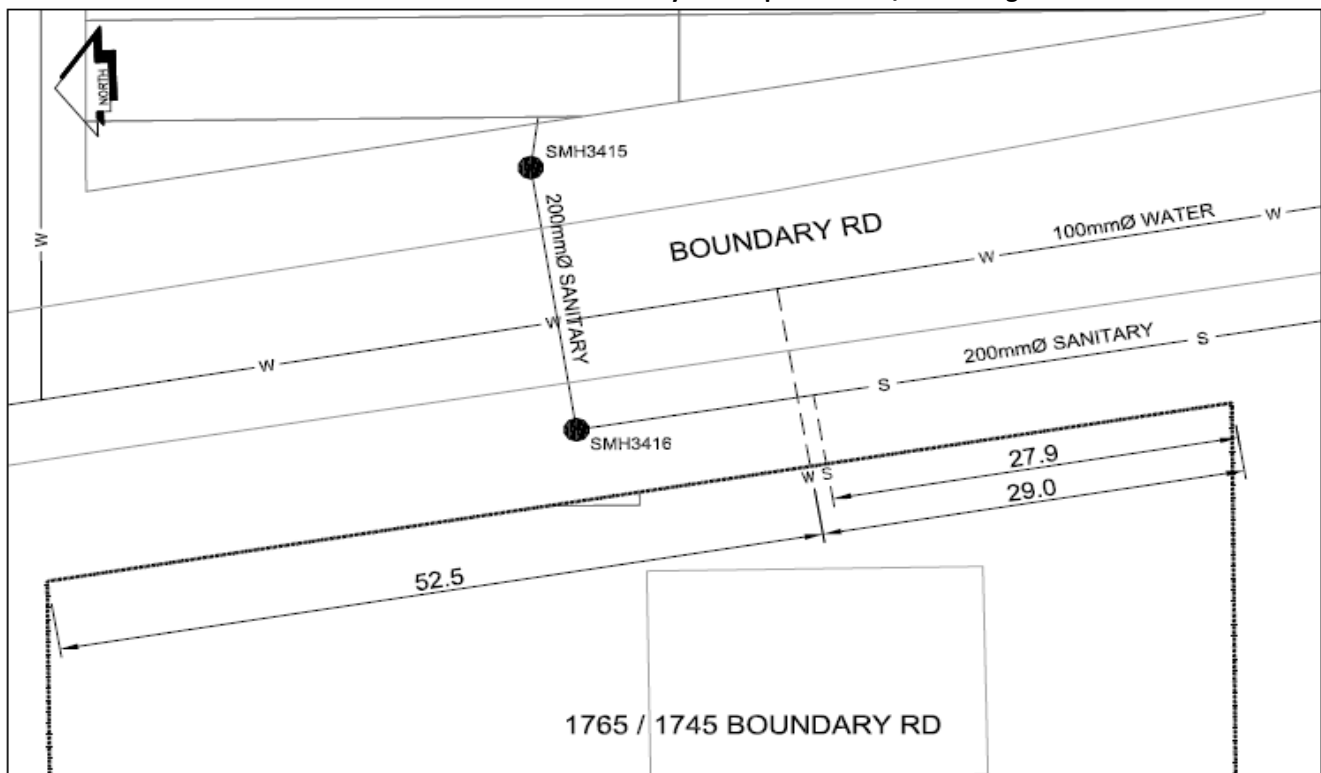

LEGEND:	CS ^o CURB STOP	--- WATER SERVICE	--- STORM SERVICE
	CO ^o CLEAN OUT	--- SANITARY SERVICE	--- GAS

NOT TO SCALE