


Lot Servicing

2397 MCTAVISH RD

Lot: A, Plan: BCP23913, DL: 4377

PID: 026679639

SERVICE	SIZE	MATERIAL	INSTALLED DATE	LOCATION	DETAILS
WATER	19MM	CU		4.90M SW E COR PL /// SP 4.5M S OF NE COR PL	THAW WIRE Y
SANITARY	100MM	PVC		4.90M SW E COR PL	DIFF OR CUT BELOW @ P/L 5.0M
STORM	100MM	PVC		4.90M SW E COR PL	DIFF OR CUT @ P/L 2.9M

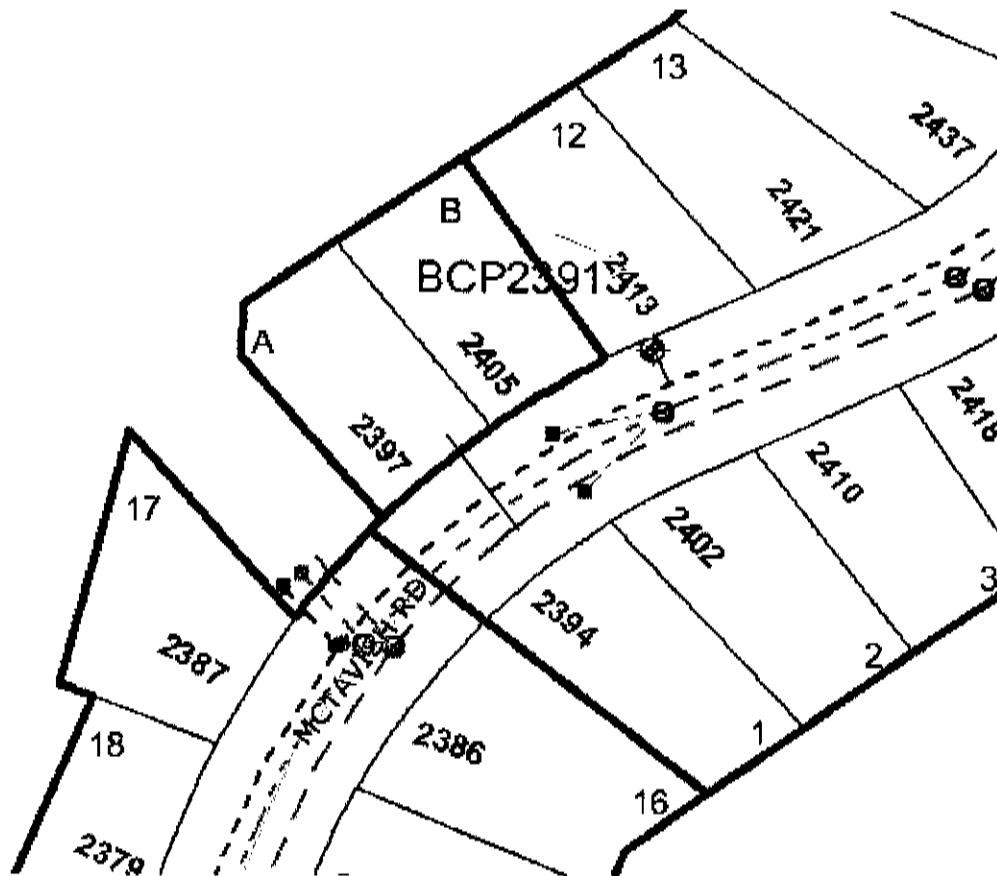

Accuracy not guaranteed unless confirmed by site inspection and/or investigation.
Connection location between main and property line only.