


## Lot Servicing

2405 MCTAVISH RD

PID: 026679647

**Lot: B, Plan: BCP23913, DL: 4377**

SERVICE	SIZE	MATERIAL	INSTALLED DATE	LOCATION	DETAILS
WATER	19MM	CU		6.18M SW OF SE COR PL /// 6.0M W OF E PL	THAW WIRE Y
SANITARY	100MM	PVC		6.18M SW OF SE COR PL	CLEANOUT 6.6M W OF E PL
STORM	100MM	PVC		6.18M SW OF SE COR PL	DIFF OR CUT @ P/L 3.0M

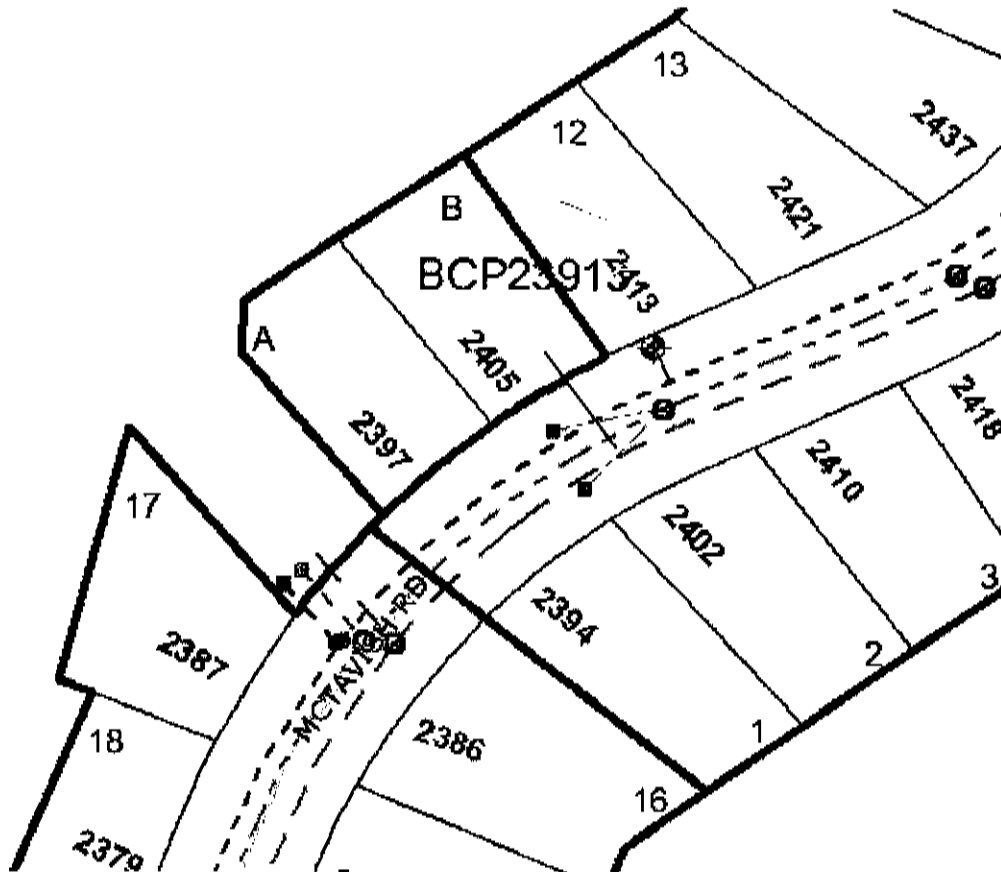

Accuracy not guaranteed unless confirmed by site inspection and/or investigation.  
Connection location between main and property line only.