


## Lot Servicing

**1675 5TH AVE**

**PID: 026706938**

Lot: C, Block: 160, Plan: 1268, DL: 343 (BA516698)

SERVICE	SIZE	MATERIAL	INSTALLED DATE	LOCATION	DETAILS
WATER	UNKNOWN	UNKNOWN		FR E COR BLD 7.312M NE 1.828M SE	CONNECTION NUMBER 2195
SANITARY	UNKNOWN	UNKNOWN		7.312M SE OF W COR PL	CONNECTION # 1719

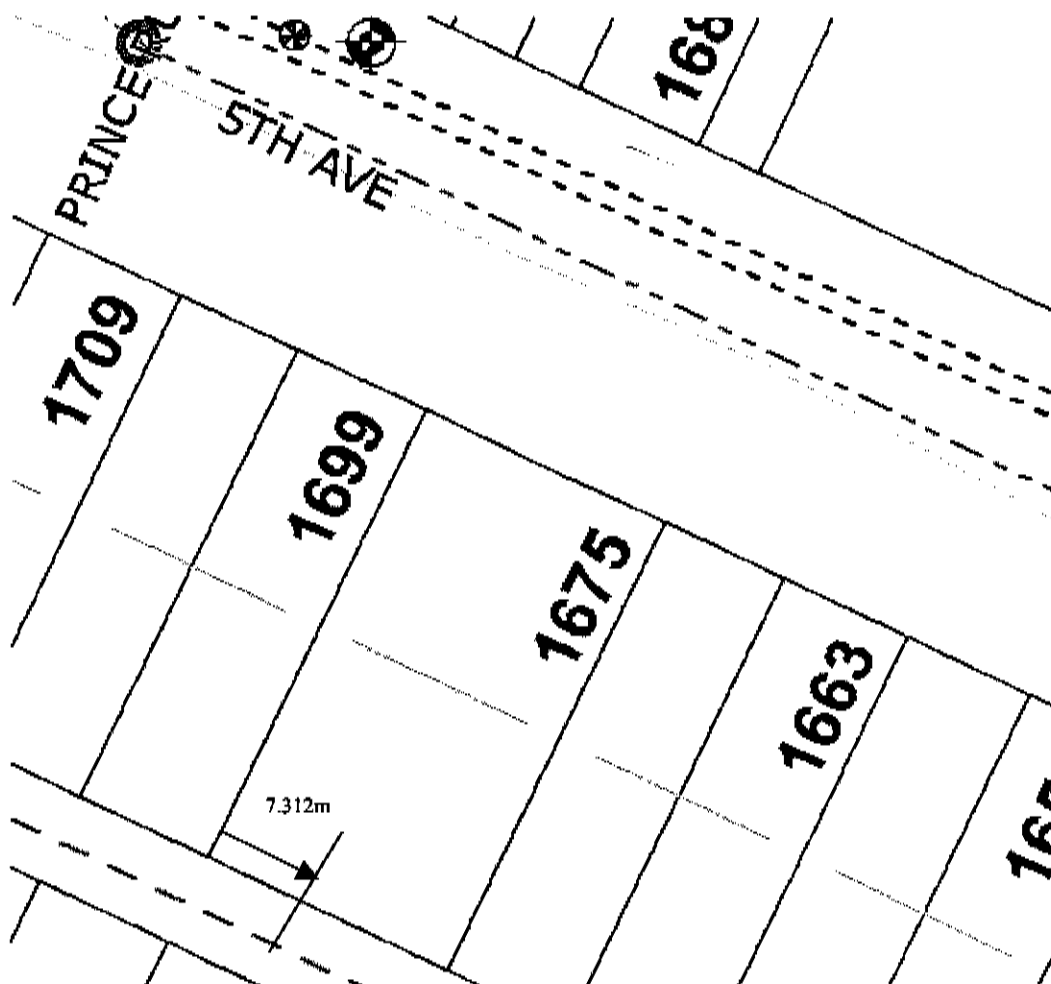

Accuracy not guaranteed unless confirmed by site inspection and/or investigation.  
Connection location between main and property line only.