


## Lot Servicing

1912 20TH AVE 1979 VINE ST

PID: **026717395**

**Lot:** PCL 1, **Plan:** BCP24383, **DL:** 343

SERVICE	SIZE	MATERIAL	INSTALLED DATE	LOCATION	DETAILS
WATER	13MM	UNKNOWN			
WATER	100MM	CU	01-Jan-1972	FR NE COR BLD 1.219M E 3.352M S	CONNECTION NUMBER 5411
WATER	13MM	UNKNOWN	31-May-1955	FR SE COR BLD 5.181M E 4.876M N	CONNECTION NUMBER 714
SANITARY	100MM	AC		5.181M S OF NE COR PL	CONNECTION # 2987
SANITARY	100MM	UNKNOWN		25.376M N OF SE COR PL	CONNECTION # 6998
STORM	200MM	UNKNOWN			CONNECTION # 322

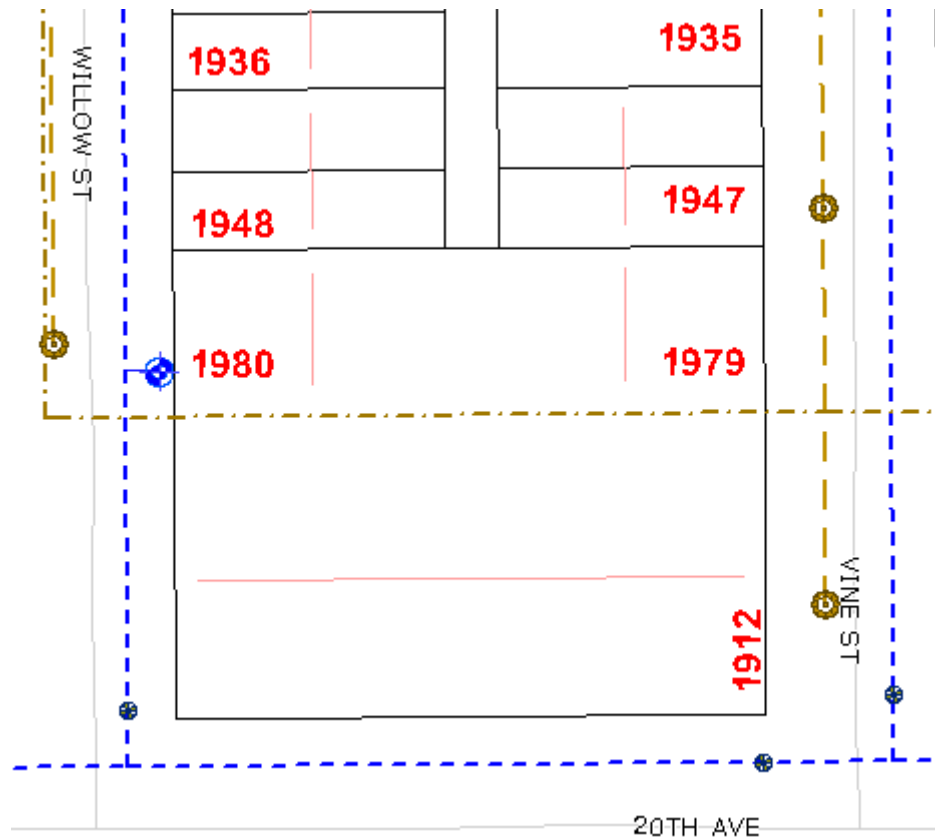

Accuracy not guaranteed unless confirmed by site inspection and/or investigation.  
Connection location between main and property line only.