

City of Prince George HISTORY SHEET

026776103

P.I.D. ~~000 000 000~~

BCP25435

Legal: LOT 9

D.L. 4377

PLAN ~~BCP20570~~

Address: 2515 McTAVISH ROAD

Sanitary Connection: SIZE: 100mm ϕ MATERIAL: PVC INV. 655.60m CONNECTED

Water Connection: SIZE: 19mm ϕ MATERIAL: COPPER INV. 655.46m METER

Storm Connection: SIZE 100mm ϕ MATERIAL PVC INV. 656.39m CONNECTED

Cash Receipt No's: WATER SANITARY STORM


CURB FROM PROPERTY LINE 5.0m PAVEMENT WIDTH 10.0m

B.C. HYDRO 75mm DB2 U/G CONNECTION


B.C. TELEPHONE 50mm DB2 U/G CONNECTION

B.C. GAS 42 PROP/P.E.

Information Sheets: REF. DWGS. L&M ENGINEERING LTD. JOB. 1253-01-03 DWGS.(001-305)

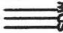Comments: CS CURB STOP  WATER SERVICE  HYDRO SERVICE
 CO CLEAN OUT  STORM SERVICE  CABLE SERVICE
  SANITARY SERVICE  TELECOMMUNICATIONS

THE INFORMATION CONTAINED HEREIN IS FOR INTERNAL USE ONLY.
 NOT TO BE RELIED UPON UNLESS CONFIRMED BY THE SITE INSPECTION AND/OR INVESTIGATION

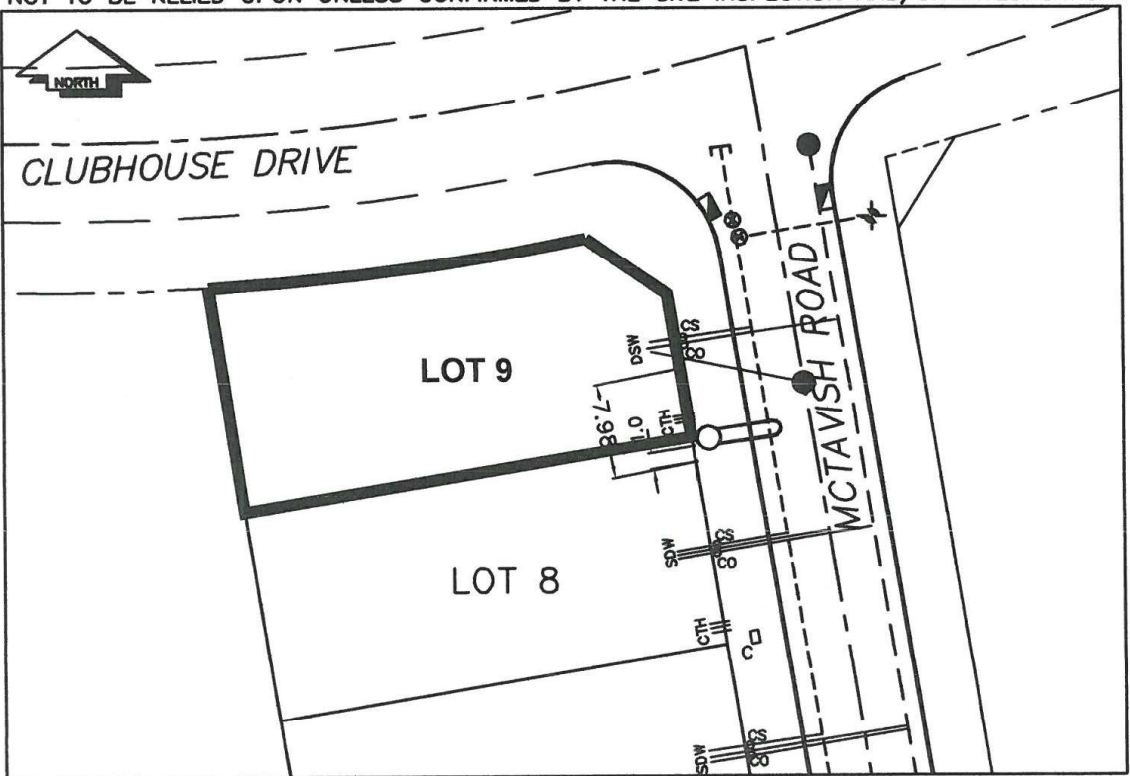

SANITARY, STORM & WATER SERVICE INVERTS	SANITARY	STORM	WATER
1. Distance from San. MH 514601 to connection point is 82.40 toward San. MH 515601 to Stm connection point is directly to Stm. MH 514601.	N/A	N/A	N/A
2. Main Size at connection point is	200mmØ	300mmØ	250mmØ
3. Invert of main at conn. stub pt is	654.55	655.42	655.16
4. Invert at service end is	654.88	655.75	655.49
5. Cut at P/I in meters	3.3m	2.5m	2.7m
6. Survey Date AUGUST 20 05 Book Ref. 1253-01-03 by KILBRIDE			

SANITARY HISTORY:

WATER HISTORY:

STORM HISTORY:
