


## Lot Servicing

**4298 DAVIS RD**

Lot: **1**, Plan: **BCP25530**, DL: **905**

**PID: 026778581**

SERVICE	SIZE	MATERIAL	INSTALLED DATE	LOCATION	DETAILS
WATER	150MM	CU	01-Nov-2001	114.40M S N PL	CASH RECEIPT NUMBER 100102
SANITARY	200MM	PVC	01-Nov-2001	115.20M S N PL	CUT @ P/L @ DATE OF INSTALLATION 1.065
STORM	300MM	PVC	01-Nov-2001		RECEIPT # 100102

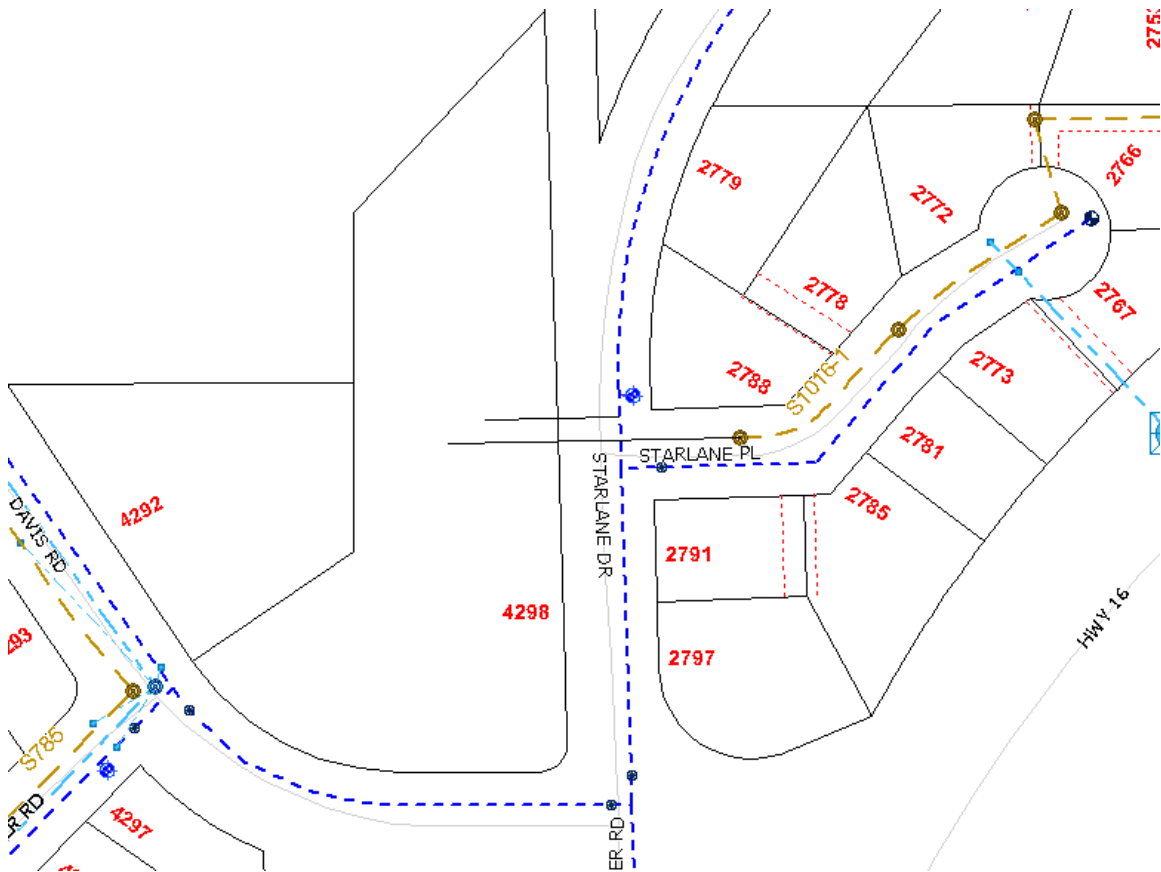

Accuracy not guaranteed unless confirmed by site inspection and/or investigation.  
Connection location between main and property line only.