


Lot Servicing

9798 PENN RD

PID: 026787792

Lot: 2, Plan: BCP25635, DL: 751

SERVICE	SIZE	MATERIAL	INSTALLED DATE	LOCATION	DETAILS

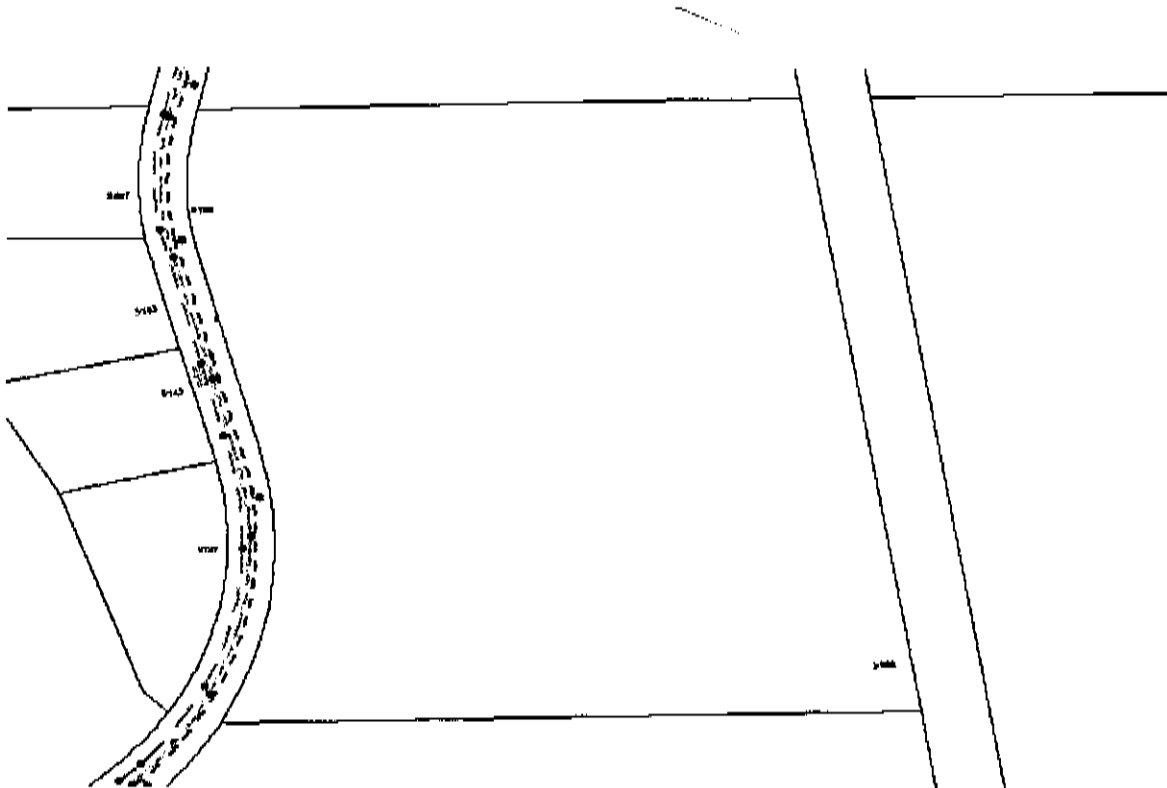

Accuracy not guaranteed unless confirmed by site inspection and/or investigation.
Connection location between main and property line only.