



City of Prince George
History Sheet

PID:	026796007
SD/MU:	
WO:	

Civic Address: 2036 Bittner Rd

Legal Description: Lot: A District Lot: 633 Plan: BCP25775


Service Type	Diameter (mm)	Material	Invert Elev at main (m)	Invert Elev at property line (m)	Invert Elev at service end (m)	Distance into property (m)	Installation Date
Sanitary	N/A	N/A	-	-	-	-	-
Water	N/A	N/A	-	-	-	-	
Storm	N/A	N/A	-	-	-	-	

Service Connection Location					Sanitary (m)	Storm (m)
Distance from downstream San MH			-	towards upstream San MH	-	
Distance from downstream Stm MH			-	towards upstream Stm MH	-	

Power	Size	Communications	Size	Cable	Size	Gas	Size
BC Hydro	-	Telus	-	Shaw	-	FortisBC	-
Overhead Service		Overhead Service		Overhead Service			

Installed by:	Survey Date:	-
Comments:		
26796007		

NOT TO SCALE The information contained herein is for internal use only.
Not to be relied on unless confirmed by site inspection and/or investigation.

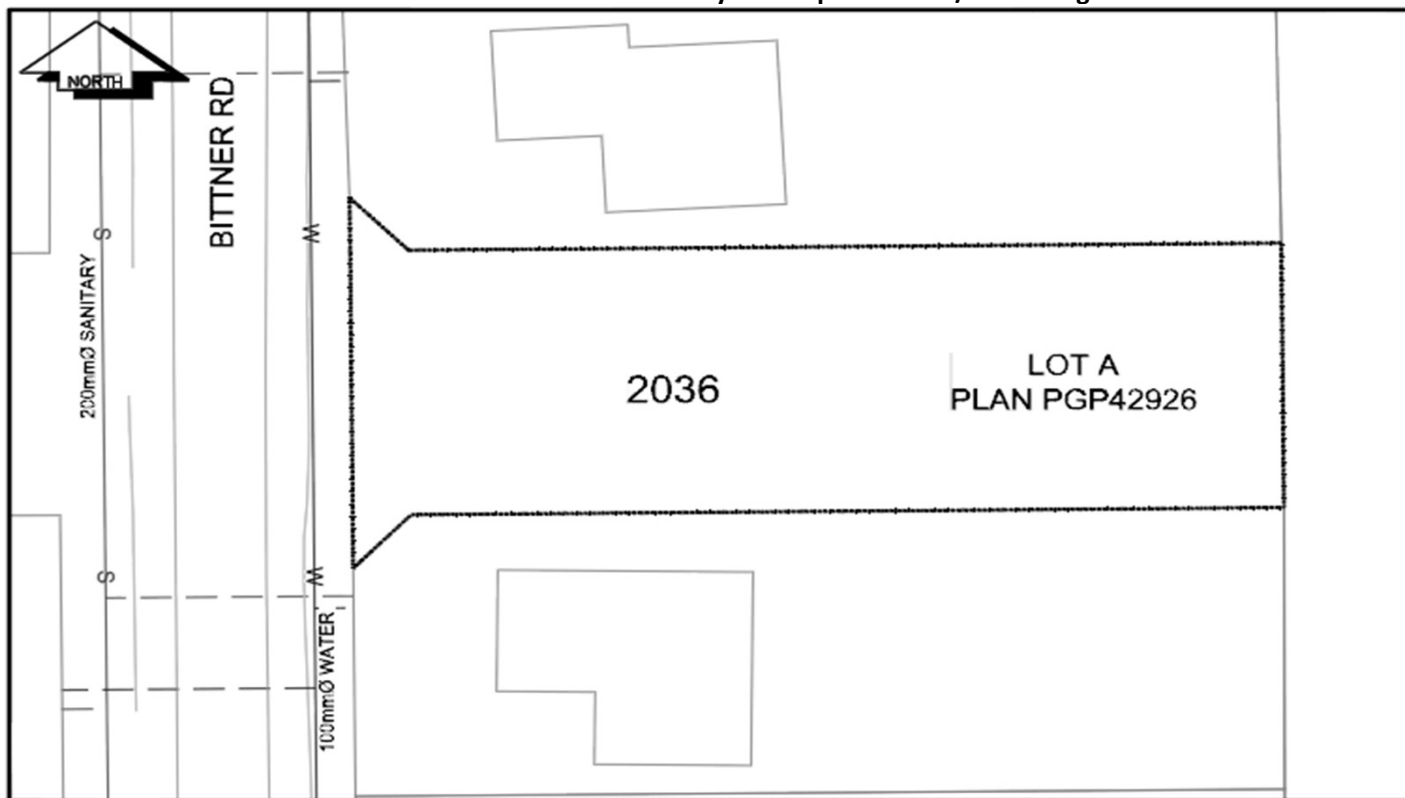

CS ^o	CURB STOP	---	WATER SERVICE	---	STORM SERVICE
CO ^o	CLEAN OUT	---	SANITARY SERVICE	---	GAS
⊗	WATER VALVE	⊗	FIRE HYDRANT	---	ENCUMBRANCE

NOT TO SCALE