


Lot Servicing

2826 ANDRES RD

PID: 026837617

Lot: 4, Plan: **BCP26497**, DL: 1433

SERVICE	SIZE	MATERIAL	INSTALLED DATE	LOCATION	DETAILS
WATER	20MM	CU	10-Dec-1990	8.0M W E PL	CASH RECEIPT NUMBER 2326
SANITARY	100MM	PVC		8.0M W E PL	RECEIPT # 2326

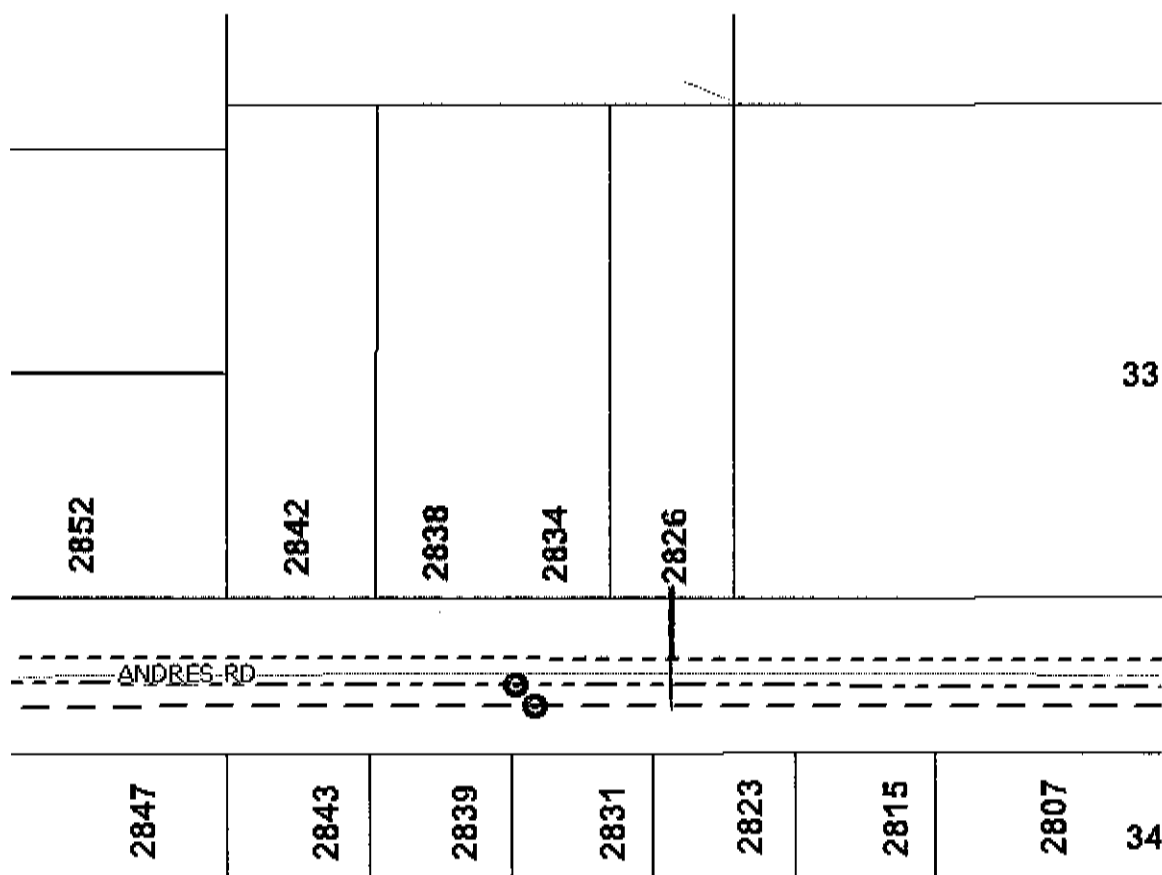

Accuracy not guaranteed unless confirmed by site inspection and/or investigation.
Connection location between main and property line only.