


## Lot Servicing

**2063 LAURIER CRES**

**PID: 026841991**

**Lot: PCL C, Block: 125, Plan: 1268, DL: 343 BA327106**

SERVICE	SIZE	MATERIAL	INSTALLED DATE	LOCATION	DETAILS
WATER	13MM	CU	09-Sep-1955	FR NW CRNR BLDG 12.192M N 2.133M E	CONNECTION NUMBER 227
SANITARY	UNKNOWN	UNKNOWN		NEAR NW PL	CONNECTION # 610

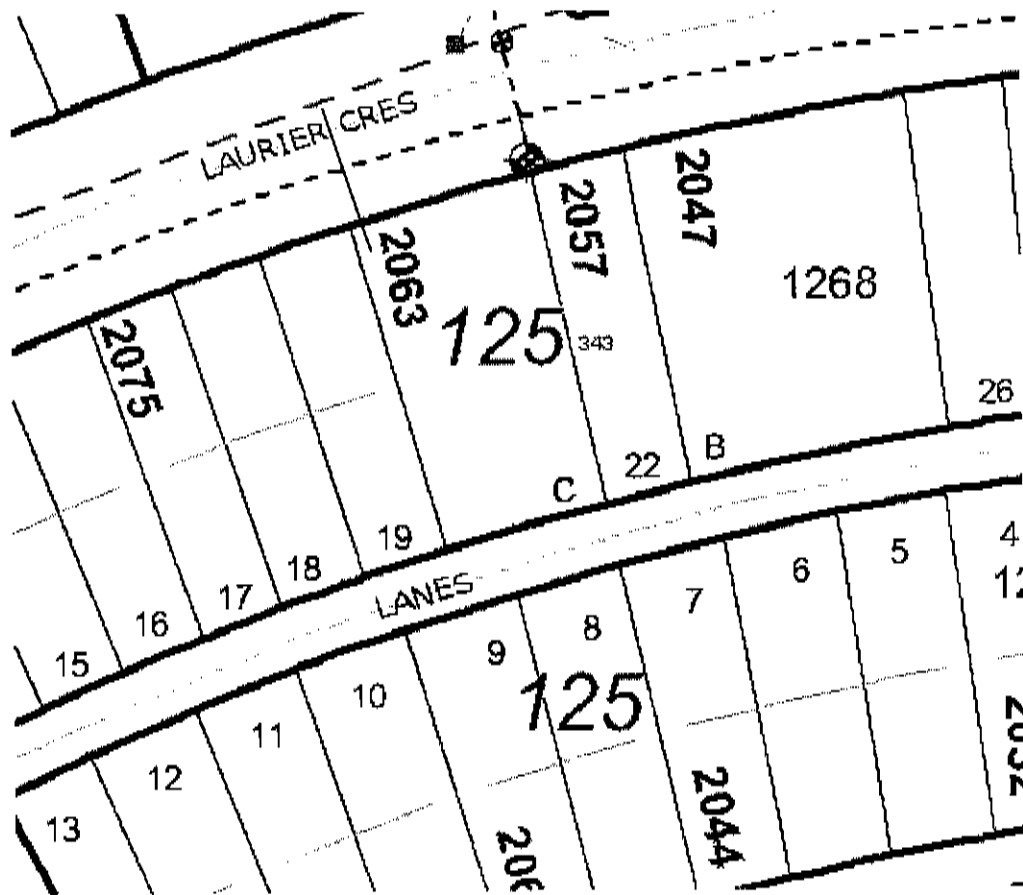

Accuracy not guaranteed unless confirmed by site inspection and/or investigation.  
Connection location between main and property line only.