


## Lot Servicing

4912 HART HWY

PID: 026929091

**Lot:** PCL 1, **Plan:** BCP27870, **DL:** 4039

SERVICE	SIZE	MATERIAL	INSTALLED DATE	LOCATION	DETAILS
WATER	25MM	CU		(LOC 1) 18.37M S OF LOWER NE COR PL	
WATER	25MM	CU		(LOC 2) 19.87M S OF LOWER NE COR PL	
WATER	25MM	CU		24.276M S OF LOWER NE COR PL	CASH RECEIPT NUMBER 5459
WATER	UNKNOWN	UNKNOWN		10.4M S OF NW COR PL	
SANITARY	100MM	PVC		(LOC 1) 9.57M S OF LOWER NE COR PL	ELEV OF INVERT @ P/L 671.85M
SANITARY	100MM	PVC		(LOC 2) 34.37M S OF LOWER NE COR PL	ELEV OF INVERT @ P/L 670.57
SANITARY	100MM	PVC		11.5M S OF LOWER NE COR PL	DIFF OR CUT BELOW @ P/L 2.800M
SANITARY	100MM	UNKNOWN		10.4M S OF NW COR PL	
STORM	150MM	PVC		(LOC 1) 10.57M S OF LOWER NE COR PL	ELEV OF INV @ P/L 671.80
STORM	150MM	PVC		(LOC 2) 34.97M S OF LOWER NE COR PL	ELEV OF INV @ P/L 670.65
STORM	150MM	PVC		12.0M S OF LOWER NE COR PL	DIFF OR CUT @ P/L 2.800M
STORM	150MM	UNKNOWN		10.4M S OF NW COR PL	

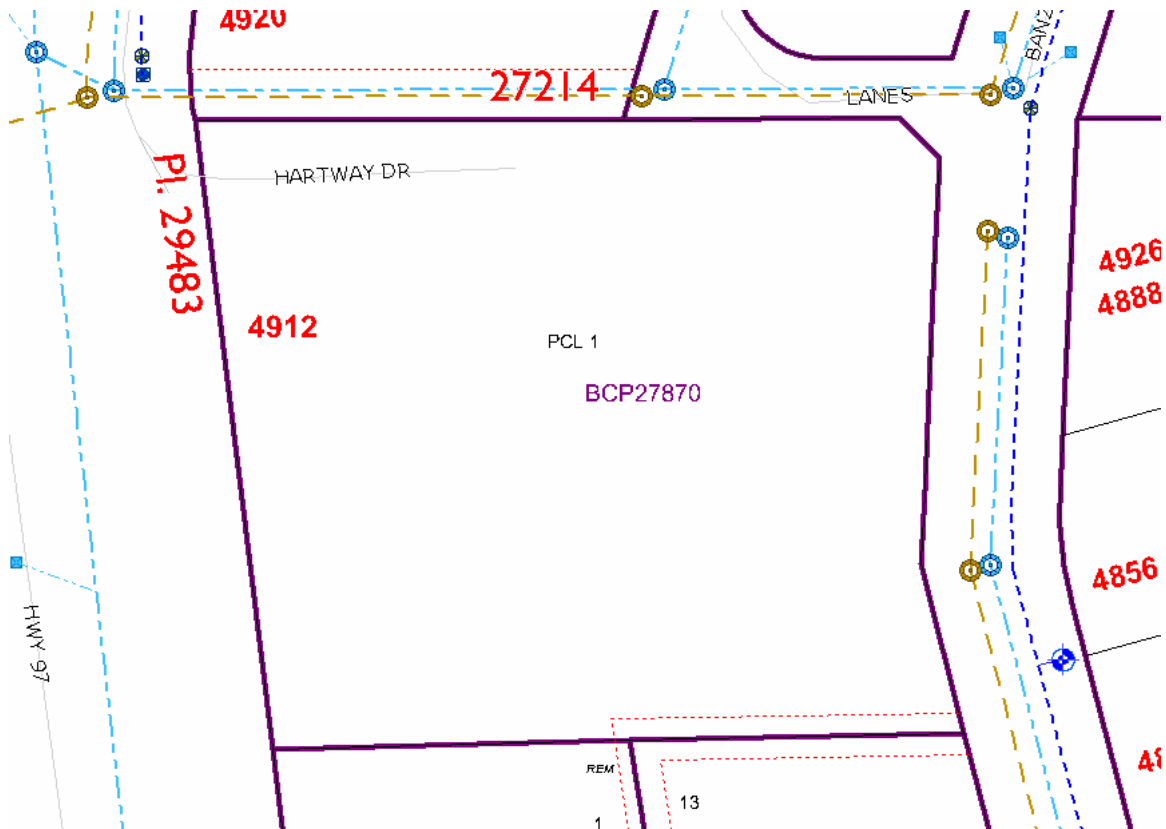

Accuracy not guaranteed unless confirmed by site inspection and/or investigation.  
 Connection location between main and property line only.