

City of Prince George

HISTORY SHEET

P.I.D. 026937590

Legal: LOT 4

482

PLAN BCP27961

Address: 430 TARA PLACE

SCALE: 1:500

Sanitary Connection: SIZE: 100mm \emptyset MATERIAL: PVC INV. 604.33m CONNECTED

Storm Connection: N/A

Water Connection: SIZE 19mm \emptyset MATERIAL COPPER INV. 604.19m METER

Cash Receipt No's: WATER SANITARY STORM

CURB FROM PROPERTY LINE 5.0m PAVEMENT WIDTH 8.5m

B.C. HYDRO 75mm DB2 U/G CONNECTION



TELUS 50mm DB2 U/G CONNECTION




TERASEN 42 PROP/P.E. U/G CONNECTION



Information Sheets: REF. DWGS. L&M ENGINEERING LTD. JOB. 1264-01-02 DWGS.(001-306)

Comments: CS₀ CURB STOP — W WATER SERVICE — H HYDRO SERVICE
CO₀ CLEAN OUT — S SANITARY SERVICE — C CABLE SERVICE
TCH TELECOMMUNICATIONS

THE INFORMATION CONTAINED HEREIN IS FOR INTERNAL USE ONLY.
NOT TO BE RELIED UPON UNLESS CONFIRMED BY THE SITE INSPECTION AND/OR INVESTIGATION

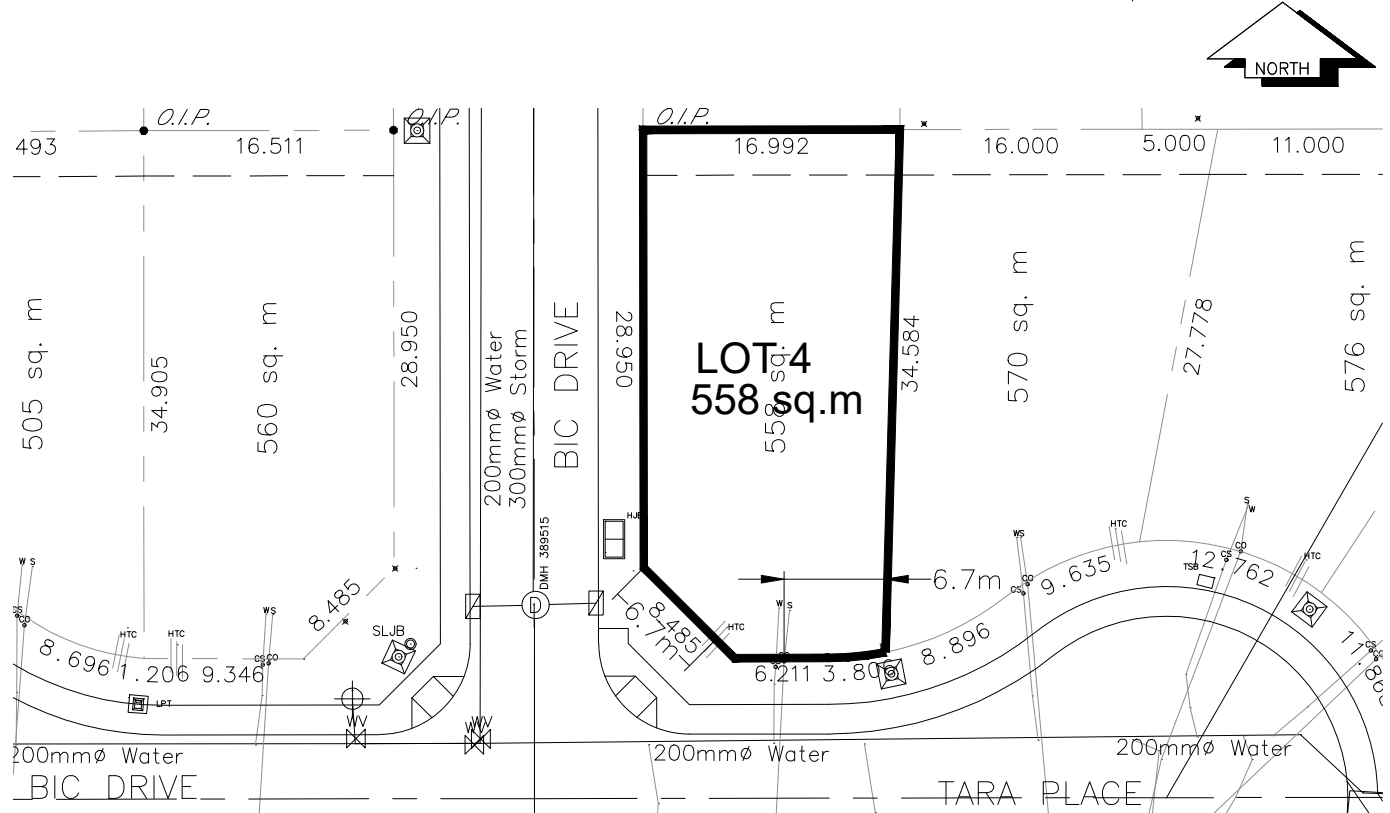

SANITARY, STORM & WATER SERVICE INVERTS	SANITARY	STORM	WATER
1. Distance from S.M.H. 389610 to connection point toward S.M.H. 389511	62.71m	N/A	N/A
2. Main Size at connection point is	200mmØ	—	200mmØ
3. Invert of main at conn. stub pt is	603.58	—	602.69
4. Invert at service end is	604.23	—	604.19
5. Cut at P/I in meters	1.97m	—	1.94m
6. Survey Date AUGUST 20 06 Book Ref. 1264—01—02 by FORESIGHT			

SANITARY HISTORY:

WATER HISTORY:

STORM HISTORY:
