
## City of Prince George HISTORY SHEET

P.I.D. 026937620				
Legal: LOT 7	D.L.	D.L. 482 PLAN BCP27961		
Address: 448 / 450 BIC DRIVE		SCALE	E: 1:500	
Sanitary Connection: SIZE: 100mmø	MATERIAL: PVC	INV. 603.99m	CONNECTED	
Storm Connection: N/A				
Water Connection: SIZE 19mmø	MATERIAL COPPER	INV. 603.87m	METER	
Cash Receipt No's: WATER	SANITARY		STORM	
CURB FROM PROPERTY LINE 5.0m		PAVEMEI	NT WIDTH 10.0m	
B.C. HYDRO 75mm DB2	U/G CONNECT	ION /		
TELUS 50mm DB2	U/G CONNECT	ION /		
TERASEN 42 PROP/P.E.	U/G CONNECT	ION /		
Information Sheets: REF. DWGS. L&M ENGINEERING LTD. JOB. 1264-01-02 DWGS.(001-306)				
CS CURB STOP ——> WATER SERVICE — ☐ HYDRO SERVICE CABLE SERVICE TELECOMMUNICATIONS  CS CURB STOP ——> WATER SERVICE — ☐ HYDRO SERVICE TELECOMMUNICATIONS				

THE INFORMATION CONTAINED HEREIN IS FOR INTERNAL USE ONLY.
NOT TO BE RELIED UPON UNLESS CONFIRMED BY THE SITE INSPECTION AND/OR INVESTIGATION

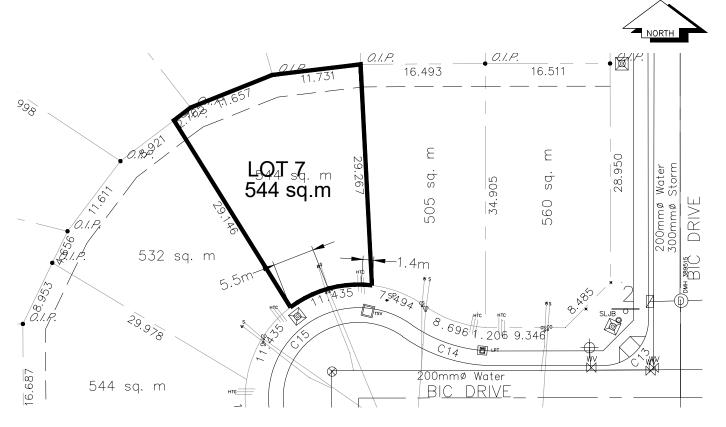

SANITARY, STORM & WATER SERVICE INVERTS	SANITARY	STORM	WATER
1. Distance from S.M.H. 389511 to connection point toward S.M.H. 389511	0.0m	N/A	N/A
2. Main Size at connection point is	200mmø	_	200mmø
3. Invert of main at conn. stub pt is	603.36	_	602.39
4. Invert at service end is	603.89	_	603.87
5. Cut at P/I in meters	2.60m	_	2.62m
6. Survey Date JANUARY 20 05 Book Ref. 1264-01-02 by MCELHANNEY			
o. darvoy batto or artor art 20 do book not.			
SANITARY HISTORY:			
WATER (WATER)			
WATER HISTORY:			
STORM HISTORY:			