

City of Prince George

HISTORY SHEET

P.I.D. 026937638

Legal: LOT 8

D.L. 482

PLAN BCP27961

Address: 453 BIC DRIVE

SCALE: 1:500

Sanitary Connection: SIZE: 100mm \emptyset MATERIAL: PVC INV. 604.07m CONNECTED

Storm Connection: N/A

Water Connection: SIZE 19mm \emptyset MATERIAL COPPER INV. 603.92m METER

Cash Receipt No's: WATER SANITARY STORM

CURB FROM PROPERTY LINE 5.0m PAVEMENT WIDTH 10.0m

B.C. HYDRO 75mm DB2 U/G CONNECTION ☒


TELUS 50mm DB2 U/G CONNECTION ☒

TERASEN 42 PROP/P.E. U/G CONNECTION ☒

Information Sheets: REF. DWGS. L&M ENGINEERING LTD. JOB. 1264-01-02 DWGS.(001-306)

Comments: CS_0 CURB STOP CO_0 CLEAN OUT $\text{---}\geq$ WATER SERVICE $\text{---}\text{S}$ SANITARY SERVICE $\text{---}\text{H}$ HYDRO SERVICE $\text{---}\text{C}$ CABLE SERVICE $\text{---}\text{TC}$ TELECOMMUNICATIONS

THE INFORMATION CONTAINED HEREIN IS FOR INTERNAL USE ONLY.
NOT TO BE RELIED UPON UNLESS CONFIRMED BY THE SITE INSPECTION AND/OR INVESTIGATION

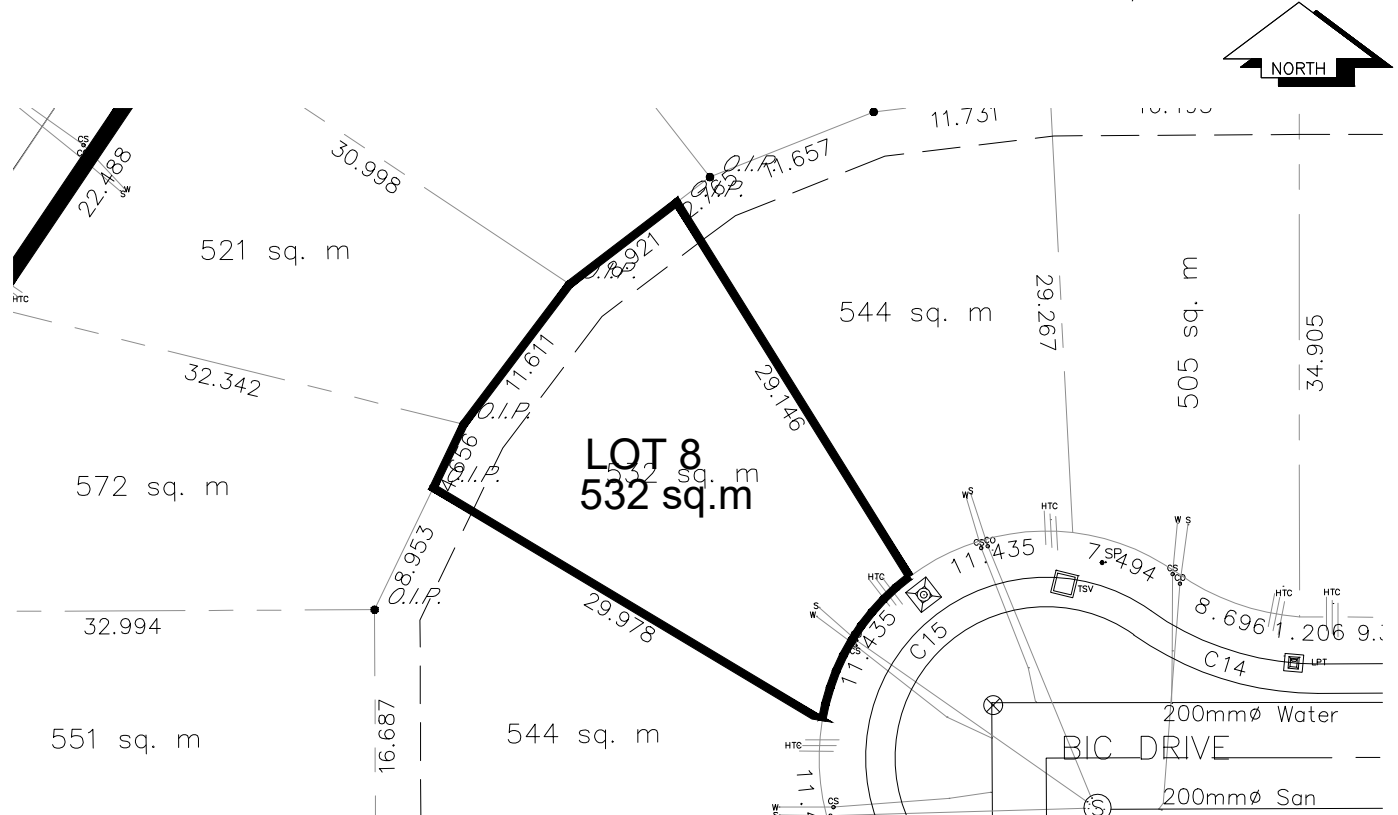

[illegible][illegible][illegible]