
City of Prince George HISTORY SHEET

P.I.D. 026937646						
Legal: LOT 9		D.L. 482	F	PLAN BCP27961		
Address: 459 BIC DRIVE		SCALE: 1:500				
Sanitary Connection: SIZE:	100mmø MATERIAL:	PVC INV.	604.01m	CONNECTED		
Storm Connection:	N/A					
Water Connection: SIZE	19mmø MATERIAL	COPPER INV.	603.89m	METER		
Cash Receipt No's:	WATER	SANITARY		STORM		
CURB FROM PROPERTY LINE 5.0m			PAVEMENT	WIDTH 10.0m		
B.C. HYDRO 75mm DB2		U/G CONNECTION				
TELUS 50mm DB2		U/G CONNECTION	/			
TERASEN 42 PROP/P.E.		U/G CONNECTION				
Information Sheets: REF. DWGS. L&M ENGINEERING LTD. JOB. 1264-01-02 DWGS.(001-306)						
Comments: CS CURB STOP COO CLEAN OUT	———≥ WATER SERVICE ——— SANITARY SERVI	CE HYDR	RO SERVICE E SERVICE COMMUNICATION	IS		

THE INFORMATION CONTAINED HEREIN IS FOR INTERNAL USE ONLY.
NOT TO BE RELIED UPON UNLESS CONFIRMED BY THE SITE INSPECTION AND/OR INVESTIGATION

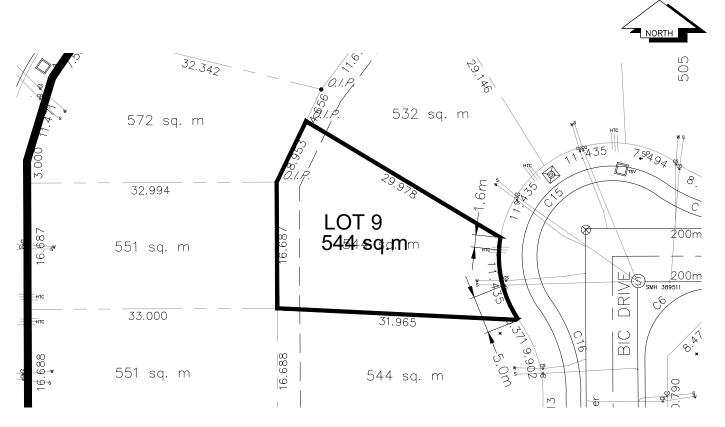

SANITARY, STORM & WATER SERVICE INVERTS	SANITARY	STORM	WATER
1. Distance from S.M.H. 389511 to connection point toward S.M.H. 389511	0.0m	N/A	N/A
2. Main Size at connection point is	200mmø	_	200mmø
3. Invert of main at conn. stub pt is	603.33	_	602.37
4. Invert at service end is	603.91	_	603.89
5. Cut at P/I in meters	2.58m	_	2.62m
6. Survey Date JANUARY 20 05 Book Ref. 1264-01-02 by MCELHANNEY			
5. Survey Batte Strate Law 25 See Book Not.			
SANITARY HISTORY:			
WATER LUCTORY			
WATER HISTORY:			
STORM HISTORY:			