
City of Prince George HISTORY SHEET

P.I.D. 026937654							
Legal: LOT 10	gal: LOT 10			482		PLAN BCP27961	
Address: 465 / 467 BIC DRIVE			SCALE: 1:500			1:500	
Sanitary Connection: SIZE:	100mmø	MATERIAL:	PVC	INV.	603.87m	CONNECTED	
Storm Connection:	N/A						
Water Connection: SIZE	19mmø	MATERIAL	COPPER	INV.	603.79m	METER	
Cash Receipt No's:	WATER		SANITARY			STORM	
CURB FROM PROPERTY LINE 5.0m					PAVEMEN	T WIDTH 8.5m	
B.C. HYDRO 75mm DB2			U/G CONNECT	ION			
TELUS 50mm DB2			U/G CONNECT	ION	/		
TERASEN 42 PROP/P.E.			U/G CONNECT	ION			
Information Sheets: REF. DWGS.	L&M ENGINEERING	G LTD. JOB	. 1264-01-02	DWGS	S.(001–306)		
Comments: CS CURB STOP COO CLEAN OUT	-	ER SERVICE IITARY SERVI	сe <u>=</u> 5	HYDR CABLE TELEC	O SERVICE E SERVICE COMMUNICATION	NS	

THE INFORMATION CONTAINED HEREIN IS FOR INTERNAL USE ONLY.
NOT TO BE RELIED UPON UNLESS CONFIRMED BY THE SITE INSPECTION AND/OR INVESTIGATION

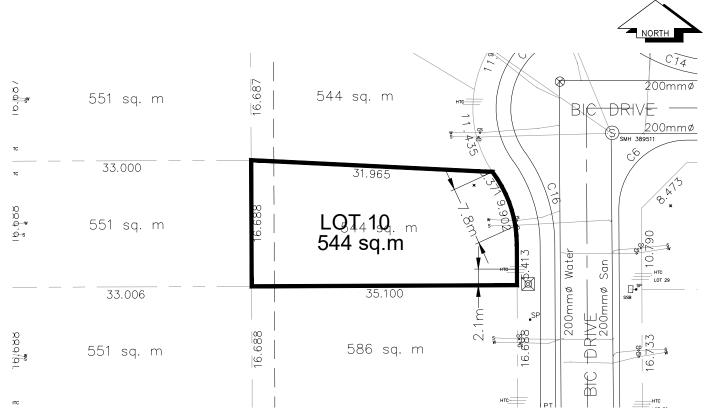

SANITARY, STORM & WATER SERVICE INVERTS	SANITARY	STORM	WATER
1. Distance from S.M.H. 389511 to connection point toward S.M.H. 389510	11.45m	N/A	N/A
2. Main Size at connection point is	200mmø	_	200mmø
3. Invert of main at conn. stub pt is	603.24	_	602.36
4. Invert at service end is	603.77	_	603.79
5. Cut at P/I in meters	2.64m	_	2.67m
6. Survey Date JANUARY 20 05 Book Ref. 1264-01-02 by MCELHANNEY			
o. Survey Bute Office And St. 120 1 31 But Mel. 120 1 31 By Manager			
			+
SANITARY HISTORY:			
WATER HISTORY:			
STORM HISTORY:			