
City of Prince George HISTORY SHEET

P.I.D. 026937662						
.egal: LOT 11			D.L. 482			PLAN BCP27961
Address: 471 / 473 BIC DRIVE					SCALE:	1:500
Sanitary Connection: SIZE:	100mmø	MATERIAL:	PVC	INV.	603.98m	CONNECTED
Storm Connection:	N/A					
Water Connection: SIZE	19mmø	MATERIAL	COPPER	INV.	603.81m	METER
Cash Receipt No's:	WATER		SANITARY			STORM
CURB FROM PROPERTY LINE 5.0m					PAVEMEN	T WIDTH 8.5m
B.C. HYDRO 75mm DB2			U/G CONNECT	ION	/	
TELUS 50mm DB2			U/G CONNECT	ION	/	
TERASEN 42 PROP/P.E.			U/G CONNECT	ION	_/	
Information Sheets: REF. DWGS.	L&M ENGINEERING	LTD. JOB.	. 1264-01-02	DWGS	S.(001–306)	
Comments: CS CURB STOP COO CLEAN OUT		ER SERVICE TARY SERVI	се <u></u> = 5	HYDR CABLE TELEC	O SERVICE E SERVICE COMMUNICATIO	NS

THE INFORMATION CONTAINED HEREIN IS FOR INTERNAL USE ONLY.
NOT TO BE RELIED UPON UNLESS CONFIRMED BY THE SITE INSPECTION AND/OR INVESTIGATION

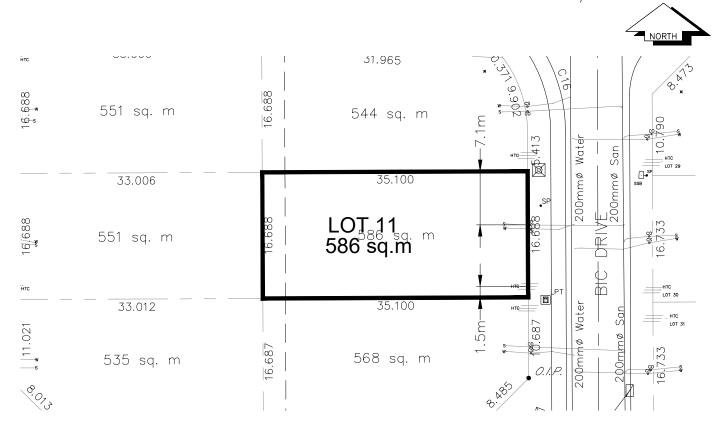

SANITARY, STORM & WATER SERVICE INVERTS	SANITARY	STORM	WATER
1. Distance from S.M.H. 389511 to connection point toward S.M.H. 389510	27.47m	N/A	N/A
2. Main Size at connection point is	200mmø	_	200mmø
3. Invert of main at conn. stub pt is	603.21	_	602.34
4. Invert at service end is	603.88	_	603.81
5. Cut at P/I in meters	2.42m	_	2.50m
6. Survey Date JANUARY 20 05 Book Ref. 1264-01-02 by MCELHANNEY			
5. Survey Batte Strate Law 25 See Book Not.			
CANITARY, HIGTORY			
SANITARY HISTORY:			
WATER HISTORY:			
WAIER HISTORY.			
CTORN, WOTORY			
STORM HISTORY:			