
## City of Prince George HISTORY SHEET

P.I.D. 026937689						
Legal: LOT 13			D.L.	482		PLAN BCP27961
Address: 483 RAV COURT					SCALE:	1:500
Sanitary Connection: SIZE:	100mmø	MATERIAL:	PVC	INV.	604.17m	CONNECTED
Storm Connection:	N/A					
Water Connection: SIZE	19mmø	MATERIAL	COPPER	INV.	604.00m	METER
Cash Receipt No's:	WATER		SANITARY			STORM
CURB FROM PROPERTY LINE 5.0m					PAVEMEN	NT WIDTH 12.0m
B.C. HYDRO 75mm DB2			U/G CONNECTI	ON	_/_	
TELUS 50mm DB2			U/G CONNECTI	ON	/	
TERASEN 42 PROP/P.E.			U/G CONNECTI	ON	_/	
Information Sheets: REF. DWGS.	L&M ENGINEERING	LTD. JOB.	1264-01-02	DWGS	5.(001–306)	)
Comments: CS CURB STOP COO CLEAN OUT	-	R SERVICE FARY SERVIC	:E ====================================	HYDRO CABLE TELEC	SERVICE SERVICE OMMUNICATION	DNS

THE INFORMATION CONTAINED HEREIN IS FOR INTERNAL USE ONLY.
NOT TO BE RELIED UPON UNLESS CONFIRMED BY THE SITE INSPECTION AND/OR INVESTIGATION

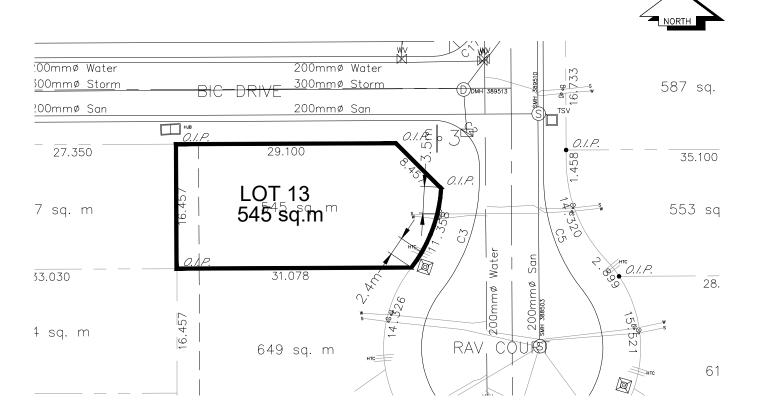

SANITARY, STORM & WATER SERVICE INVERTS	SANITARY	STORM	WATER
1. Distance from S.M.H. 388503 to connection point toward S.M.H. 389510	17.86m	N/A	N/A
2. Main Size at connection point is	200mmø	_	200mmø
3. Invert of main at conn. stub pt is	603.13	_	602.65
4. Invert at service end is	604.07	_	604.00
5. Cut at P/I in meters	2.34m	_	2.41m
6. Survey Date JANUARY 20 05 Book Ref. 1264-01-02 by MCELHANNEY			
,			
SANITARY HISTORY:			
SANITART MISTORT.			
WATER HISTORY:			
STORM HISTORY:			