
City of Prince George HISTORY SHEET

P.I.D. 026937697						
Legal: LOT 14			D.L.	482		PLAN BCP27961
Address: 489 / 491 RAV COURT					SCALE:	1:500
Sanitary Connection: SIZE:	100mmø	MATERIAL:	PVC	INV.	604.17m	CONNECTED
Storm Connection:	N/A					
Water Connection: SIZE	19mmø	MATERIAL	COPPER	INV.	604.07m	METER
Cash Receipt No's:	WATER		SANITARY			STORM
CURB FROM PROPERTY LINE 5.0m					PAVEMEI	NT WIDTH 12.0m
B.C. HYDRO 75mm DB2			U/G CONNECT	ION	_/_	
TELUS 50mm DB2			U/G CONNECT	ION	_/_	
TERASEN 42 PROP/P.E.			U/G CONNECT	ION	_/_	
Information Sheets: REF. DWGS.	L&M ENGINEERING	LTD. JOB.	. 1264-01-02	DWGS	S.(001–306)
Comments: CS CURB STOP COO CLEAN OUT	-	ER SERVICE TARY SERVI	E = ==================================	HYDR CABLE TELEC	O SERVICE E SERVICE COMMUNICATION	ONS

THE INFORMATION CONTAINED HEREIN IS FOR INTERNAL USE ONLY.

NOT TO BE RELIED UPON UNLESS CONFIRMED BY THE SITE INSPECTION AND/OR INVESTIGATION

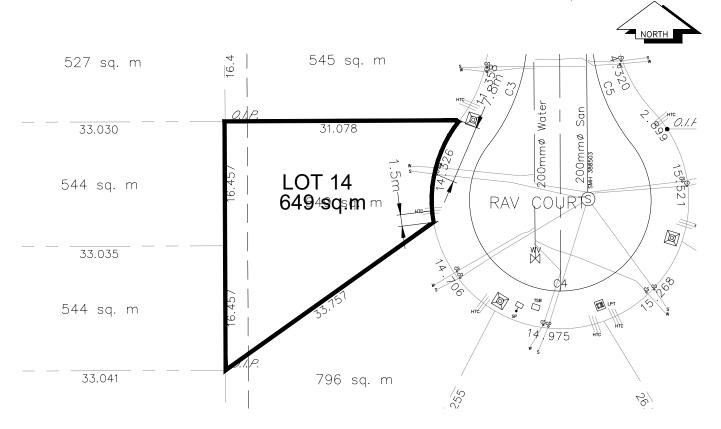

SANITARY, STORM & WATER SERVICE INVERTS	SANITARY	STORM	WATER
1. Distance from S.M.H. 388503 to connection point toward S.M.H. 388503	0.0m	N/A	N/A
2. Main Size at connection point is	200mmø	_	200mmø
3. Invert of main at conn. stub pt is	603.28	_	602.91
4. Invert at service end is	604.07	_	604.07
5. Cut at P/I in meters	2.53m	-	2.53m
6. Survey Date JANUARY 20 05 Book Ref. 1264-01-02 by MCELHANNEY			
5, 54, 75, 77, 77, 77, 77, 77, 77, 77, 77, 77			
SANITARY HISTORY:			
WATER AUGTORY			
WATER HISTORY:			
STORM HISTORY:			